



BRIGHTON WASTEWATER TREATMENT SYSTEM UPGRADES 100 COUNTY ROAD 64, BRIGHTON, ONTARIO DRAWING: SITE WIDE WATERPROOFING PLAN

J.L.Richards ENGINEERS - ARCHITECTS - PLANNERS

This drawing is copyright protected and may not be reproduced or used for purposes other than execution of the described work without the express written consent of J.L. Richards & Associates Limited


DESIGN: SC/KA


DRAWN: NP


CHECKED: HB/SC

JLR #: 32296-001

DRAWING #: A-SK001

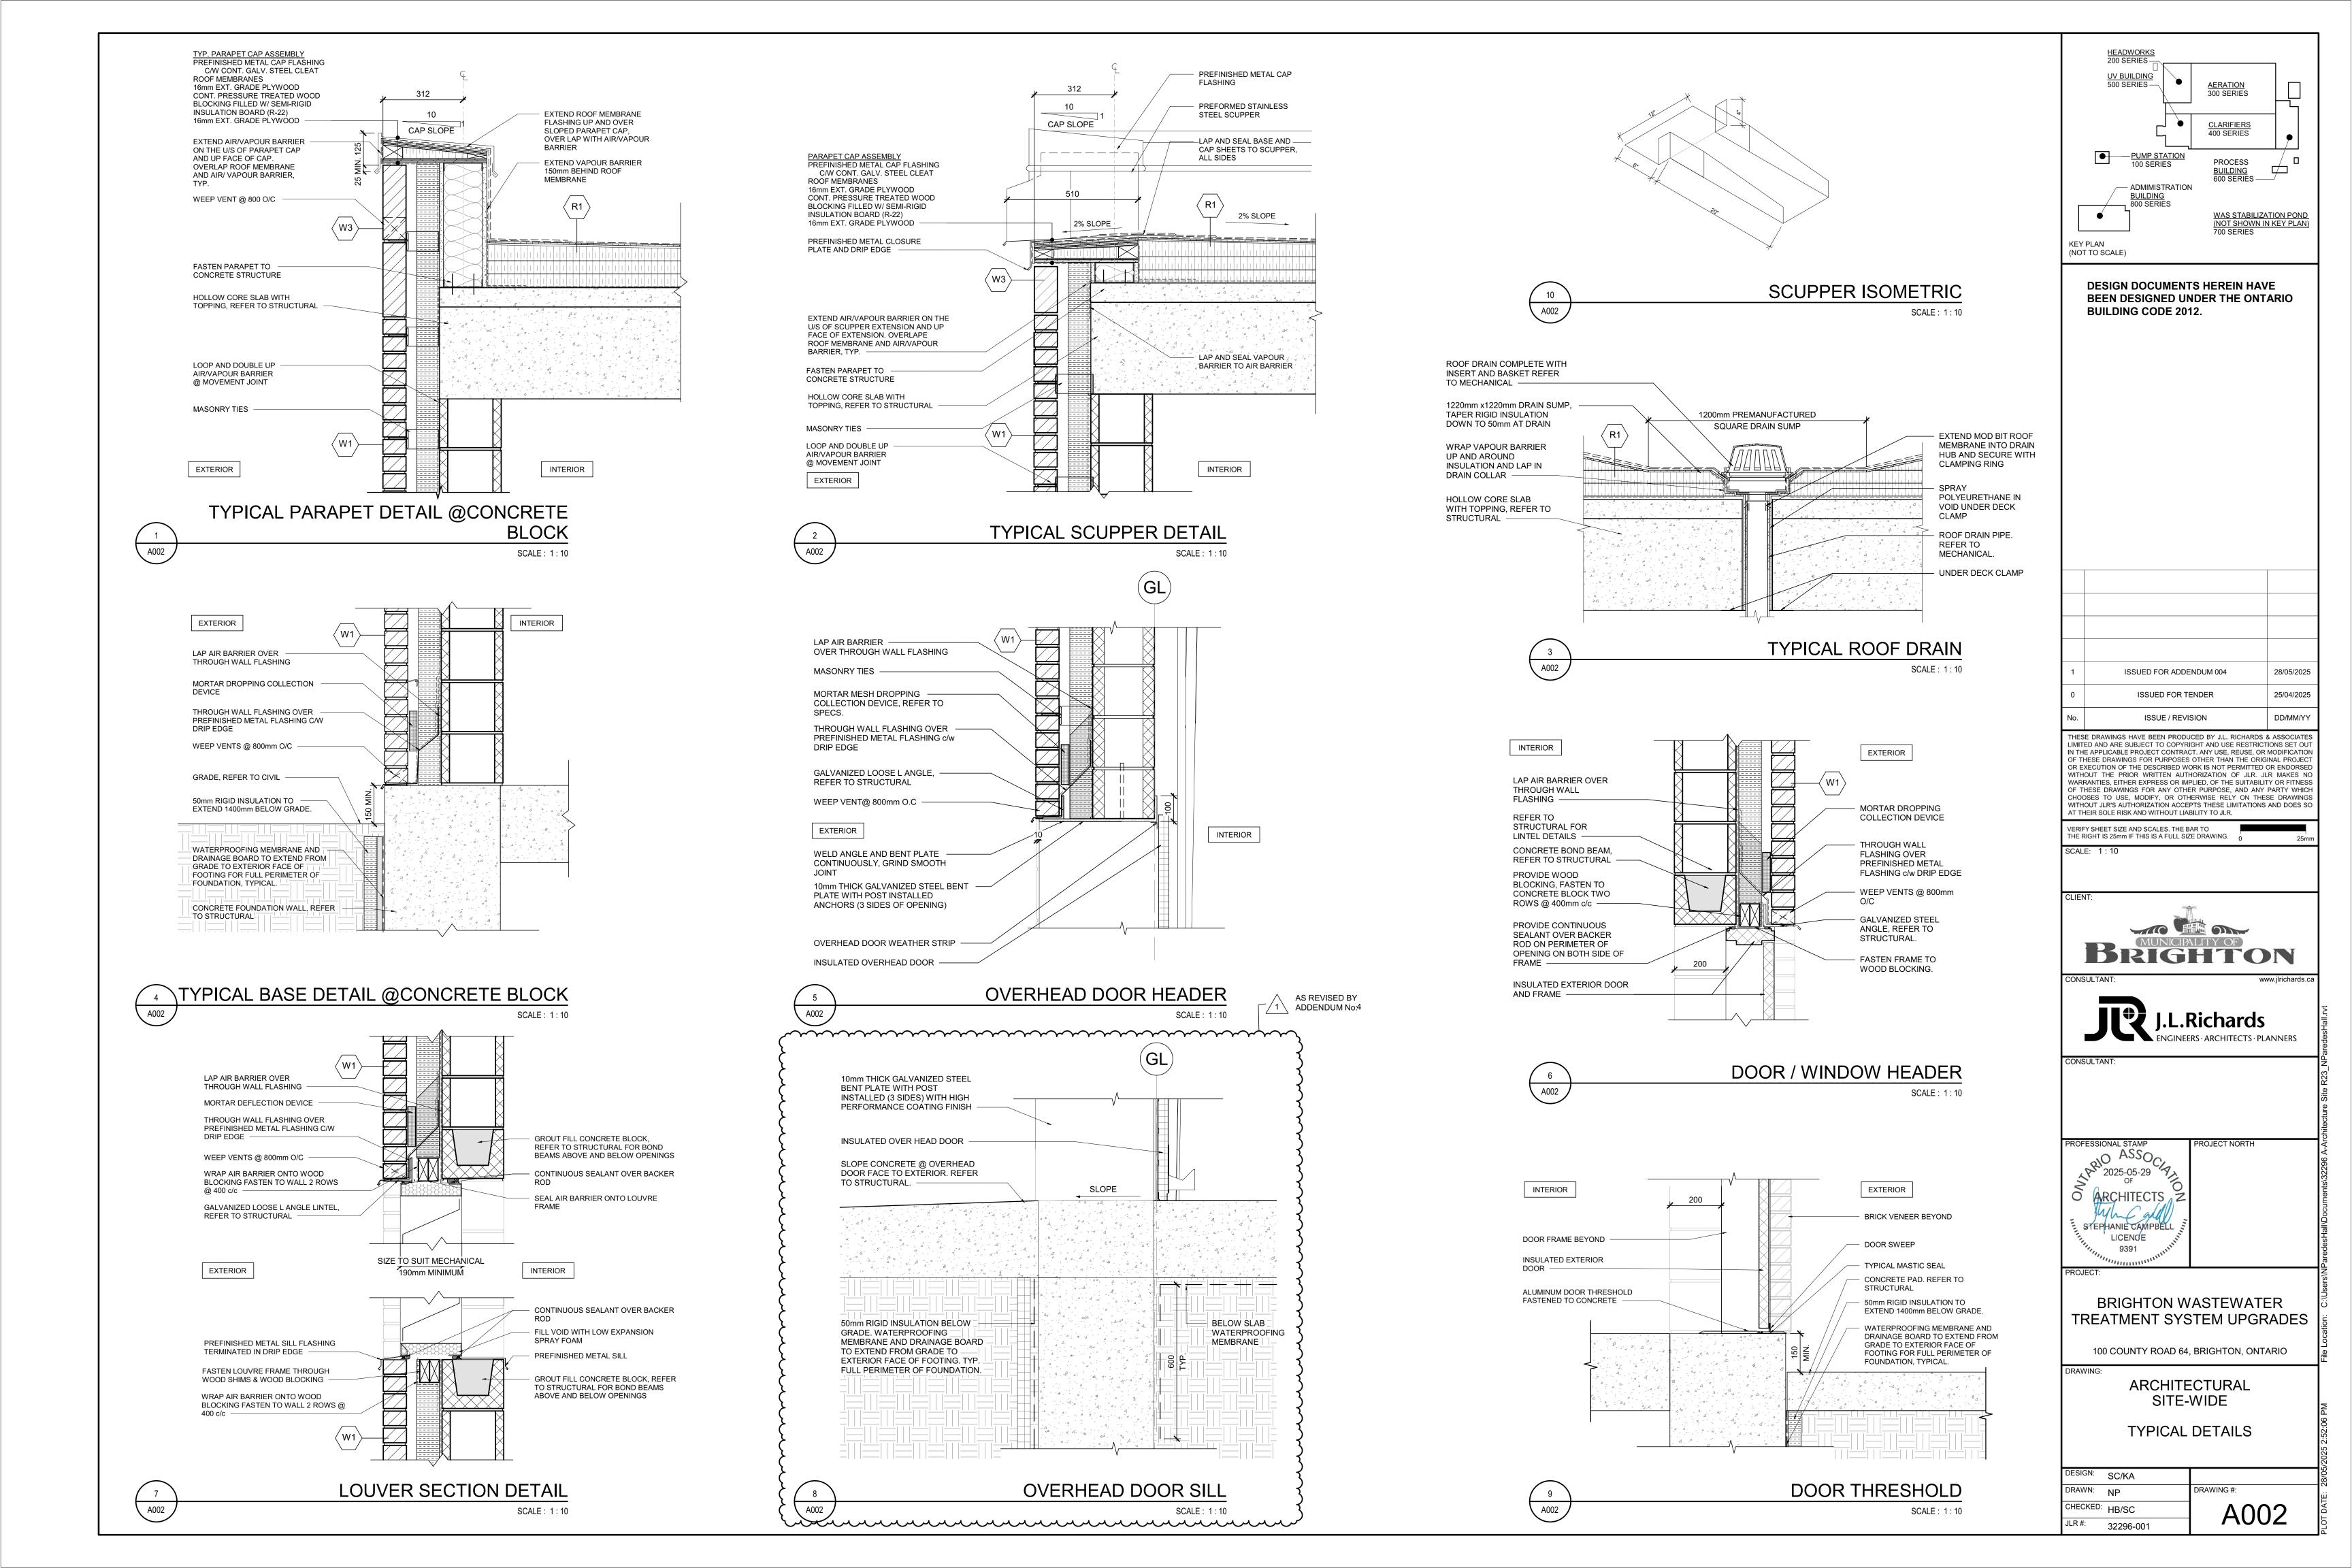


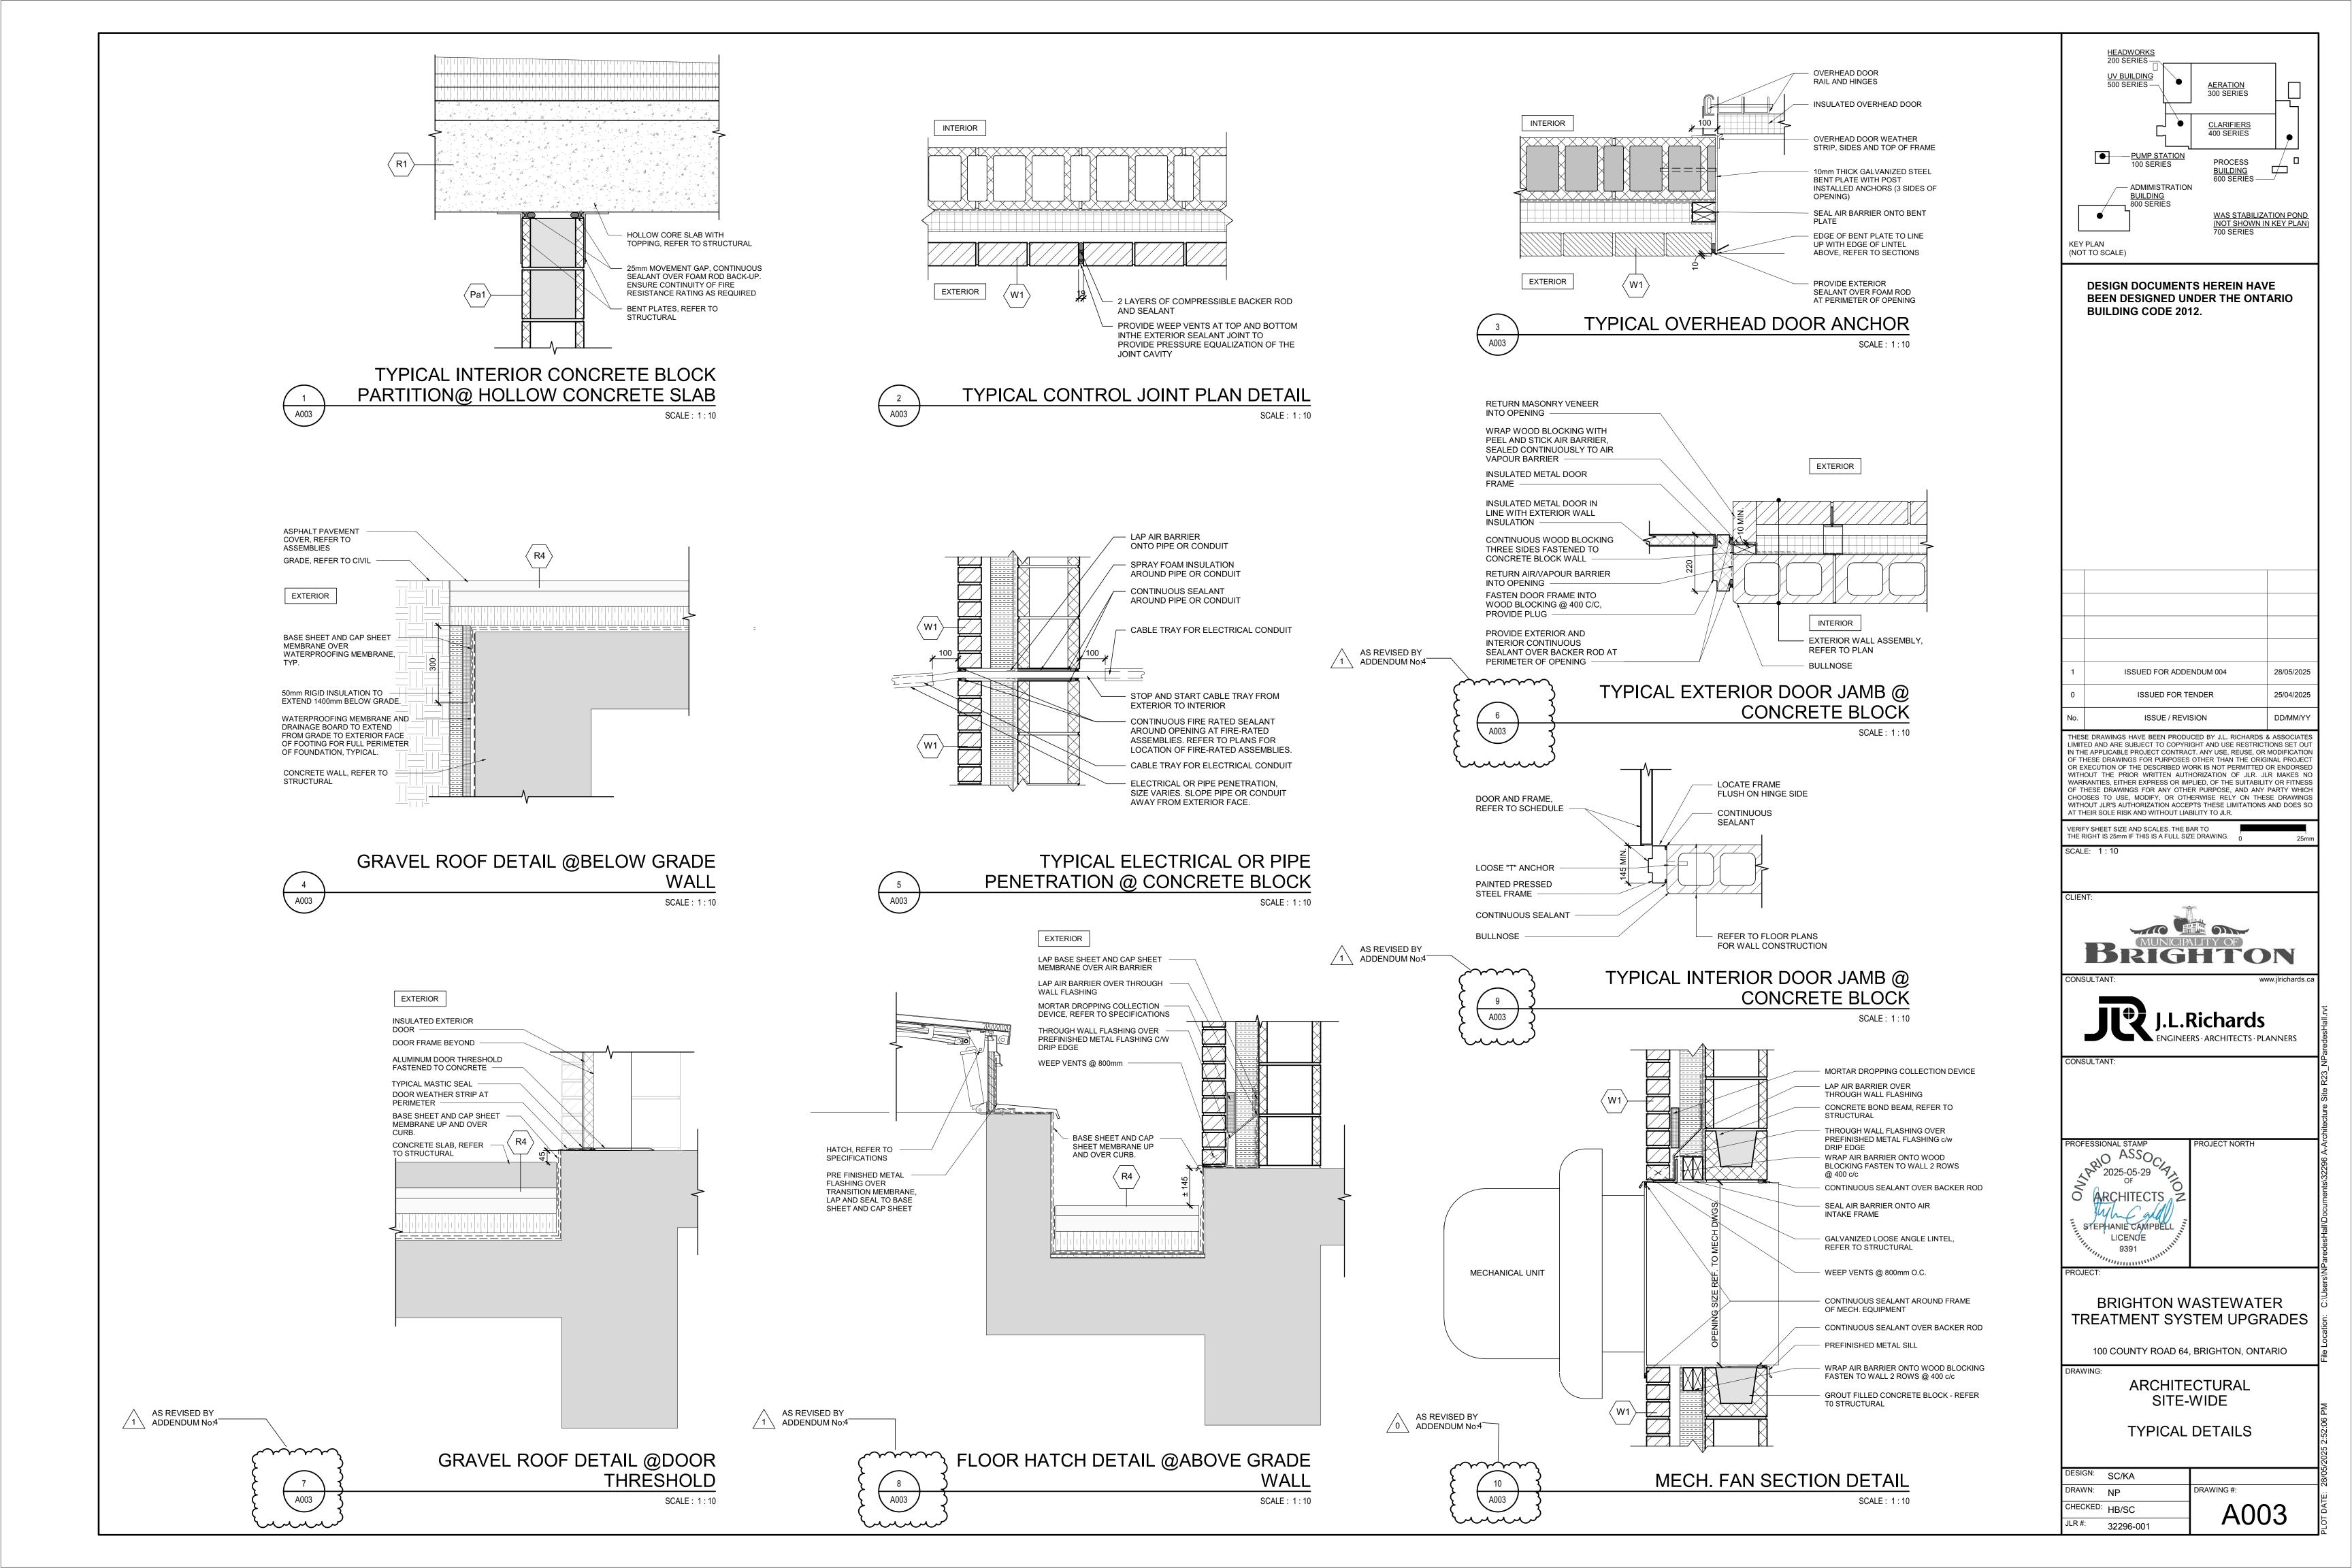

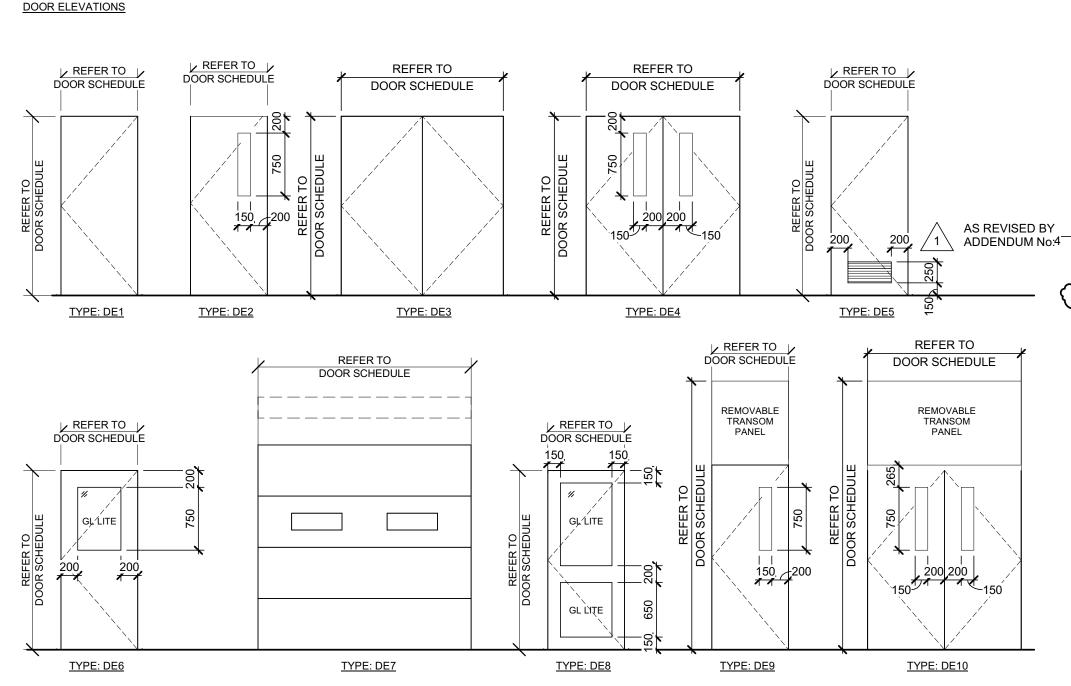


#### **DOOR NOTES:**

- REFER TO DOOR AND FRAME SCHEDULE FOR DOOR HEIGHTS AND WIDTHS.
   TEMPERED GLAZING IN ALL INTERIOR DOORS, UNLESS OTHERWISE NOTED.
- 3. INSULATED TEMPERED GLAZING IN EXTERIOR DOORS AND TRANSOMS.
- 4. FIRE RATED GLAZING IN ALL FIRE RATED DOORS, REFER TO SCHEDULE.
- 5. DOORS IN FIRE RATED ASSEMBLIES TO BE SMOKE SEALED. 6. PROVIDE DOOR RESTRAINT SYSTEM FOR ALL OVERHEAD DOORS, BY PRO-PORTES (WWW.PRO-PORTES.COM). SYSTEM TO BE INTERLOCKED
- WITH THE DOOR OPERATOR MOTOR IN ORDER TO CUT OFF POWER TO THE OPERATOR WHEN RESTRAINT SYSTEM IS ENGAGED. 7. REFER TO SPECIFICATIONS FOR GLAZING DETAILS

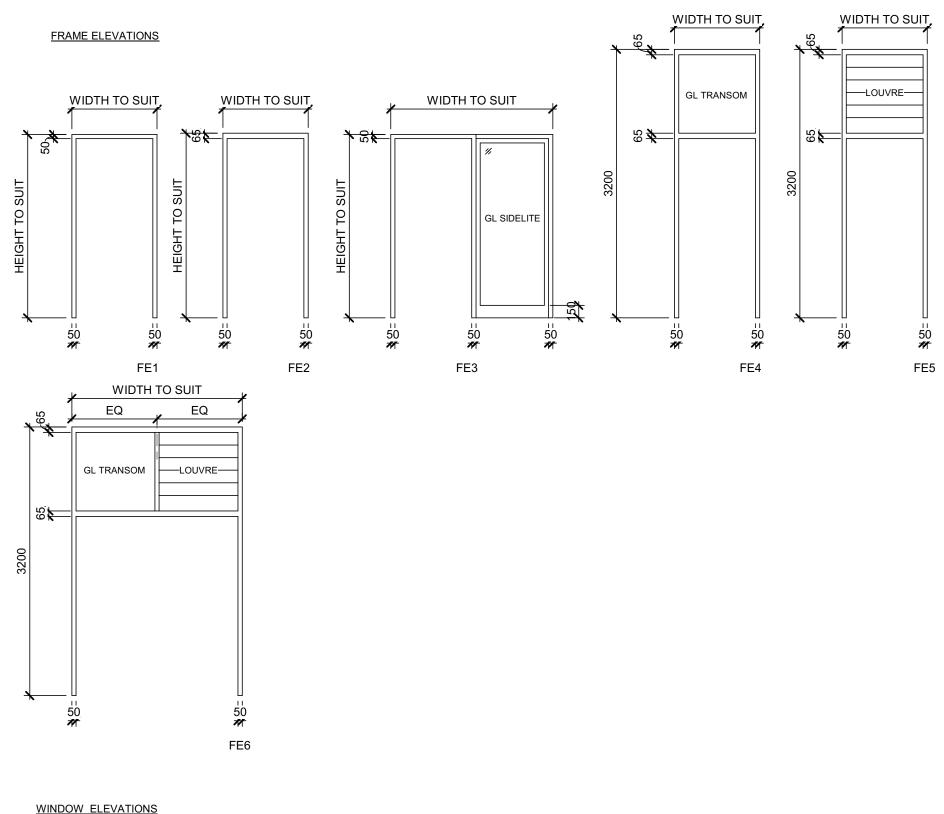

## WINDOW ELEVATIONS

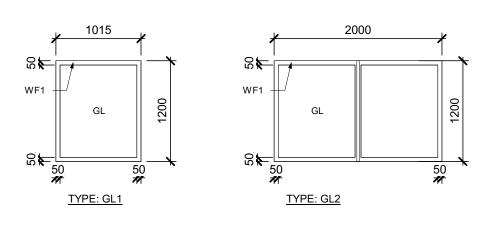

		HATCH	SCHEDULE1	
Building	HATCH NUMBER	HATCH SIZE		REMARKS
PROCESS BUILDING	H3	1900 x 800	REFER TO SPECIFICATIONS	

					R	OOM FI	NISH	SCHEDU	LE							
		FLOO	R					WALLS					CEILING			
				NO	RTH	EAS	ST	SOUT	ТН	WE	ST				FIRE	
ROOM No.	NAME	FINISH	BASE	MATERIAL	FINISH	MATERIAL	FINISH	MATERIAL	FINISH	MATERIAL	FINISH	MATERIAL	FINISH	HEIGHT	RATING	REMARKS
000	COREEN AND RECRIT DOOM	00		0.0		0.0		OD		0.0						
200	SCREEN AND DEGRIT ROOM  ELECTRICAL ROOM	SC EP	-	CB CB	- DT	CB CB	PT	CB CB	- PT	CB CB	- PT	ES ES	-	-	-	
201 202	MECHANICAL ROOM	SC	-	СВ	PT PT	СВ	PT	СВ	PT	СВ	PT	ES	-	-	-	
202	SCREENINGS BIN ROOM	SC	-	CB	-	СВ	-	CB	<u> </u>	CB	<u>-</u>	ES		-	_	
301	TUNNEL	SC	<del>-</del>	EC	EC -	EC	EC	EC	EC	EC	EC EC	ES		_	_	
500	UV DISINFECTION CHANNEL	SC	<del>-</del>	CB	-	CB		CB	-	CB	-	ES		_	_	
501	ELECTRICAL ROOM	EP	-	CB	PT	CB	PT	CB	PT	CB	PT	ES	_	_	_	
502	EXIT STAIRS	SC	-	CB	- ' '	CB		CB	EC	CB	- ' '	ES	-	_	_	
503	MECHANICAL ROOM	SC		CB	PT	CB	PT	CB	PT	CB	PT	ES	_	_	_	
504	ELECTRICAL ROOM BASEMENT LEVEL	SC	-	CB		CB		CB		CB		ES	_	-	_	
600	BLOWER ROOM	SC	-	CB	-/AP	СВ	-/AP	CB	-/AP	CB	-/AP	ES	-	-	-	REFER TO PLAN AND WALL SECTION FOR EXTENT OF AP
601	MECHANICAL ROOM	SC		СВ	PT	СВ	PT	СВ	PT	СВ	PT	ES	_	_	_	
603	ELECTRICAL ROOM  ELECTRICAL ROOM		~~	CB		I CB I	PT	CB	PT	l CB l	PT	l ES l	-	-	-	
1 <del>004</del>	PROCESS BUILDING BASEMENT	my m		سيتس		with	PT	CB	PT	CB CB	PT	MES W	-	-	-	
605	PROCESS BUILDING BASEMENT  EXIT STAIRS	sc	بيد	EC/CB	<u>~</u> -	EC/CB	PT -	EC/CB	PT -	EC/CB	TPT -	ES ES	<u>.</u>	<u>.</u>	-	
604 605 800	EXIT STAIRS CORRIDOR	SC VT	- RB	EC/CB GB	PT	EC/CB GB	PT - PT	EC/CB GB	PT - PT	EC/CB GB	PT - PT	ES ES ACT		- 2700		
605 800 801	EXIT STAIRS CORRIDOR LUNCH / MEETING ROOM	SC VT VT	- RB RB	EC/CB GB GB	PT PT	EC/CB GB GB	PT PT PT	EC/CB GB GB	PT PT PT	EC/CB GB GB	PT - PT PT	ES ES ACT ACT	- - -	- 2700 2700	- - -	
604 605 800 801 802	EXIT STAIRS CORRIDOR LUNCH / MEETING ROOM OFFICE	SC VT VT VT	- RB RB RB	EC/CB GB GB GB	PT PT PT	EC/CB GB GB GB	PT PT PT PT PT	EC/CB GB GB GB	PT - PT - PT - PT - PT	EC/CB GB GB GB	PT - PT PT PT	ES ES ACT ACT ACT	- - - - -	- 2700 2700 2700 2700	- - - -	
605 800 801	EXIT STAIRS CORRIDOR LUNCH / MEETING ROOM	SC VT VT	- RB RB	EC/CB GB GB	PT PT	EC/CB GB GB	PT PT PT	EC/CB GB GB	PT PT PT	EC/CB GB GB	PT - PT PT	ES ES ACT ACT	- - -	- 2700 2700	- - -	
604 605 800 801 802 803	EXIT STAIRS CORRIDOR LUNCH / MEETING ROOM OFFICE LABORATORY	SC VT VT VT VT	- RB RB RB RB	EC/CB GB GB GB GBM	PT PT PT PT	EC/CB GB GB GB GBM	PT PT PT PT PT PT	EC/CB GB GB GB GB GBM	PT PT PT PT PT	EC/CB GB GB GB GB GBM	PT PT PT PT PT	ES ES ACT ACT ACT ACT	- - - - -	- 2700 2700 2700 2700 2700	- - - - - -	REFER TO INTERIOR ELEVATIONS FOR
605 800 801 802 803 804	EXIT STAIRS CORRIDOR LUNCH / MEETING ROOM OFFICE LABORATORY UNIVERSAL WASHROOM	SC VT VT VT CT	- RB RB RB CT	EC/CB GB GB GB GBM CT/GWBM	PT PT PT PT -/PT	EC/CB GB GB GB GBM CT/GWBM	PT PT PT PT PT -/PT	EC/CB GB GB GB GB CT/GWBM	PT - PT PT PT PT -/PT	EC/CB GB GB GB GB CT/GWBM	PT PT PT PT PT -/PT	ES ES ACT ACT ACT ACT ACT	- - - - - - -	- 2700 2700 2700 2700 2700 2700	- - - - - - -	REFER TO INTERIOR ELEVATIONS FOR
605 800 801 802 803 804	EXIT STAIRS CORRIDOR LUNCH / MEETING ROOM OFFICE LABORATORY UNIVERSAL WASHROOM  DOCUMENT ROOM	SC VT VT VT CT VT	RB RB RB CT RB	EC/CB GB GB GB GBM CT/GWBM	PT PT -/PT PT	EC/CB GB GB GB GBM CT/GWBM	PT PT PT PT -/PT PT	EC/CB GB GB GB GBM CT/GWBM	PT PT PT PT PT PT PT	EC/CB GB GB GB GBM CT/GWBM	PT PT PT PT -/PT PT	ES ES ACT ACT ACT ACT ACT ACT ACT	- - - - - - -	2700 2700 2700 2700 2700 2700 2700	- - - - - - -	REFER TO INTERIOR ELEVATIONS FOR
605 800 801 802 803 804 805 806	EXIT STAIRS CORRIDOR LUNCH / MEETING ROOM OFFICE LABORATORY UNIVERSAL WASHROOM  DOCUMENT ROOM JANITOR'S CLOSET	SC S	RB RB CT RB RB	EC/CB GB GB GB CT/GWBM GB GBM	PT PT -/PT PT PT PT PT	EC/CB GB GB GB CT/GWBM GB GBM	PT	EC/CB GB GB GB GBM CT/GWBM	PT	CB EC/CB GB GB GB CT/GWBM	PT	ES ES ACT ACT ACT ACT ACT ACT ACT ES	- - - - - - -	- 2700 2700 2700 2700 2700 2700	- - - - - - - -	REFER TO INTERIOR ELEVATIONS FOR EXTENT OF CT  REFER TO INTERIOR ELEVATIONS FOR
604 605 800 801 802 803 804 805 806 807	EXIT STAIRS CORRIDOR LUNCH / MEETING ROOM OFFICE LABORATORY UNIVERSAL WASHROOM  DOCUMENT ROOM JANITOR'S CLOSET MEN'S WASHROOM / CHANGE ROOM	SC VT VT VT CT VT SC CT	RB RB CT RB RB CT	EC/CB GB GB GB CT/GWBM GB GBM CT/GWBM	PT PT PT -/PT PT -/PT	EC/CB GB GB GB CT/GWBM GB GBM CT/GWBM	PT	EC/CB GB GB GB GBM CT/GWBM  GB GBM CT/GWBM	PT PT PT PT -/PT PT -/PT	CB EC/CB GB GB GBM CT/GWBM	PT	ES ES ACT ACT ACT ACT ACT ACT ES GBM/ACT	- - - - - - - -	2700 2700 2700 2700 2700 2700 2700 - 2700	- - - - - - - -	REFER TO INTERIOR ELEVATIONS FOR EXTENT OF CT  REFER TO INTERIOR ELEVATIONS FOR EXTENT OF CT  REFER TO INTERIOR ELEVATIONS FOR
605 800 801 802 803 804 805 806 807	EXIT STAIRS CORRIDOR LUNCH / MEETING ROOM OFFICE LABORATORY UNIVERSAL WASHROOM  DOCUMENT ROOM JANITOR'S CLOSET MEN'S WASHROOM / CHANGE ROOM  WOMEN'S WASHROOM / CHANGE ROOM	SC VT VT VT CT VT SC CT CT	RB RB CT RB RB CT CT	EC/CB GB GB GB GBM CT/GWBM GB GBM CT/GWBM CT/GWBM	- PT PT -/PT -/PT	EC/CB GB GB GB CT/GWBM CT/GWBM CT/GWBM	PT PT PT PT -/PT PT -/PT -/PT	EC/CB GB GB GB GBM CT/GWBM GB GBM CT/GWBM CT/GWBM	PT	EC/CB GB GB GB GBM CT/GWBM GB GBM CT/GWBM CT/GWBM	- PT PT PT PT -/PT -/PT -/PT	ES ES ACT ACT ACT ACT ACT ACT ACT GBM/ACT	- - - - - - - -	2700 2700 2700 2700 2700 2700 2700 2700	- - - - - - - -	REFER TO INTERIOR ELEVATIONS FOR EXTENT OF CT  REFER TO INTERIOR ELEVATIONS FOR EXTENT OF CT  REFER TO INTERIOR ELEVATIONS FOR
605 800 801 802 803 804 805 806 807 808	EXIT STAIRS CORRIDOR LUNCH / MEETING ROOM OFFICE LABORATORY UNIVERSAL WASHROOM  DOCUMENT ROOM JANITOR'S CLOSET MEN'S WASHROOM / CHANGE ROOM  WOMEN'S WASHROOM / CHANGE ROOM  ELECTRICAL ROOM	SC	RB RB CT RB	EC/CB GB GB GB GBM CT/GWBM GB GBM CT/GWBM CT/GWBM	- PT PT -/PT -/PT PT	EC/CB GB GB GB GBM CT/GWBM  GB GBM CT/GWBM  CT/GWBM	PT	EC/CB GB GB GB GBM CT/GWBM GB GBM CT/GWBM CT/GWBM	PT P	EC/CB  EC/CB  GB  GB  GB  CT/GWBM  CT/GWBM  CT/GWBM  CT/GWBM	PT P	ES ES ACT ACT ACT ACT ACT ACT CS GBM/ACT ES GBM/ACT ES	- - - - - - - -	2700 2700 2700 2700 2700 2700 2700 - 2700	- - - - - - - -	REFER TO INTERIOR ELEVATIONS FOR EXTENT OF CT  REFER TO INTERIOR ELEVATIONS FOR EXTENT OF CT  REFER TO INTERIOR ELEVATIONS FOR
604 605 800 801 802 803 804 805 806 807 808	EXIT STAIRS  CORRIDOR  LUNCH / MEETING ROOM  OFFICE  LABORATORY  UNIVERSAL WASHROOM  DOCUMENT ROOM  JANITOR'S CLOSET  MEN'S WASHROOM / CHANGE ROOM  WOMEN'S WASHROOM / CHANGE ROOM  ELECTRICAL ROOM  MECHANICAL ROOM	SC SC VT VT VT CT SC CT CT EP SC	RB RB CT CT CT RB RB RB	EC/CB GB GB GB GBM CT/GWBM GB GBM CT/GWBM CT/GWBM	- PT PT PT -/PT PT -/PT -/PT PT PT PT PT PT PT	EC/CB GB GB GB GBM CT/GWBM  GB GBM CT/GWBM  CT/GWBM	PT PT PT PT PT PT -/PT PT -/PT PT PT PT PT PT PT PT PT PT	CB EC/CB GB GB GB GBM CT/GWBM  CT/GWBM  CT/GWBM  CT/GWBM	PT PT PT PT PT -/PT PT -/PT PT PT PT PT PT PT	CB EC/CB GB GB GB CT/GWBM  CT/GWBM  CT/GWBM  CT/GWBM	PT PT PT PT PT PT PT -/PT PT PT PT PT PT PT PT PT	ES ES ES ACT ACT ACT ACT ACT ES GBM/ACT ES ES ES	- - - - - - - -	2700 2700 2700 2700 2700 2700 2700 - 2700 2700	- - - - - - - - -	REFER TO INTERIOR ELEVATIONS FOR EXTENT OF CT  REFER TO INTERIOR ELEVATIONS FOR EXTENT OF CT  REFER TO INTERIOR ELEVATIONS FOR
804 805 800 801 802 803 804 805 806 807 808 809 810 812	EXIT STAIRS  CORRIDOR  LUNCH / MEETING ROOM  OFFICE  LABORATORY  UNIVERSAL WASHROOM  DOCUMENT ROOM  JANITOR'S CLOSET  MEN'S WASHROOM / CHANGE ROOM  WOMEN'S WASHROOM / CHANGE ROOM  ELECTRICAL ROOM  MECHANICAL ROOM  SCADA ROOM	SC VT VT VT CT VT SC CT CT EP SC VT	RB RB CT CT CT RB RB RB RB	EC/CB GB GB GB GBM CT/GWBM GB GBM CT/GWBM CT/GWBM	- PT PT -/PT -/PT PT PT PT PT PT PT PT	EC/CB GB GB GB GBM CT/GWBM GB GBM CT/GWBM CT/GWBM	PT	EC/CB GB GB GB GBM CT/GWBM  CT/GWBM  CT/GWBM  CT/GWBM	PT PT PT PT PT -/PT PT P	CB EC/CB GB GB GB GBM CT/GWBM  GB GBM CT/GWBM  CT/GWBM  CT/GWBM	PT PT PT PT PT -/PT  PT	ES ES ACT ACT ACT ACT ACT ACT  ACT  GBM / ACT  ES ES ES ACT	- - - - - - - - -	2700 2700 2700 2700 2700 2700 2700 - 2700 - 2700	- - - - - - - - -	REFER TO INTERIOR ELEVATIONS FOR EXTENT OF CT  REFER TO INTERIOR ELEVATIONS FOR EXTENT OF CT  REFER TO INTERIOR ELEVATIONS FOR
804 805 800 801 802 803 804 805 806 807 808 809 810 812 813	EXIT STAIRS  CORRIDOR  LUNCH / MEETING ROOM  OFFICE  LABORATORY  UNIVERSAL WASHROOM  DOCUMENT ROOM  JANITOR'S CLOSET  MEN'S WASHROOM / CHANGE ROOM  WOMEN'S WASHROOM / CHANGE ROOM  ELECTRICAL ROOM  MECHANICAL ROOM  SCADA ROOM  IT CLOSET	SC VT VT SC CT CT EP SC VT VT VT VT	RB RB CT CT CT RB RB RB RB RB RB	EC/CB GB GB GB GBM CT/GWBM GB GBM CT/GWBM CT/GWBM CT/GWBM	- PT PT -/PT -/PT PT P	EC/CB GB GB GB GBM CT/GWBM  GB GBM CT/GWBM  CT/GWBM  CT/GWBM	PT	EC/CB GB GB GB GBM CT/GWBM  CT/GWBM  CT/GWBM  CT/GWBM  GB	PT PT PT PT -/PT -/PT -/PT -/PT -/PT -/P	CB EC/CB GB GB GB GBM CT/GWBM  GB GBM CT/GWBM  CT/GWBM  CT/GWBM  CT/GWBM  GB GB GB GB GB GB GB	PT PT PT PT PT -/PT  PT	ES ES ACT ACT ACT ACT ACT ACT ES GBM/ACT  ES ES ACT ACT	- - - - - - - - - -	2700 2700 2700 2700 2700 2700 2700 - 2700 - 2700 - 2700 2700	- - - - - - - - - -	REFER TO INTERIOR ELEVATIONS FOR EXTENT OF CT  REFER TO INTERIOR ELEVATIONS FOR EXTENT OF CT  REFER TO INTERIOR ELEVATIONS FOR
804 605 800 801 802 803 804 805 806 807 808 809 810 812 813 814	EXIT STAIRS  CORRIDOR  LUNCH / MEETING ROOM  OFFICE  LABORATORY  UNIVERSAL WASHROOM  DOCUMENT ROOM  JANITOR'S CLOSET  MEN'S WASHROOM / CHANGE ROOM  WOMEN'S WASHROOM / CHANGE ROOM  ELECTRICAL ROOM  MECHANICAL ROOM  SCADA ROOM  IT CLOSET  CONTROL ROOM	SC VT VT SC CT CT EP SC VT	RB RB CT CT CT RB RB RB RB RB RB RB RB RB	EC/CB GB GB GB GBM CT/GWBM GB GBM CT/GWBM CT/GWBM GB GB GB GB GB GB GB GB	- PT PT -/PT PT P	EC/CB GB GB GB GBM CT/GWBM  CT/GWBM  CT/GWBM  CT/GWBM  CT/GWBM  CT/GWBM  GB GB GB GB GB GB GB	PT P	EC/CB GB GB GB GBM CT/GWBM  CT/GWBM  CT/GWBM  CT/GWBM  GB	PT PT PT PT PT -/PT -/PT -/PT -/PT -/PT	CB EC/CB GB GB GB GBM CT/GWBM  CT/GWBM  CT/GWBM  CT/GWBM  CT/GWBM  CT/GWBM  CT/GWBM  CT/GWBM	PT PT PT PT PT -/PT -/PT -/PT -/PT -/PT	ES ES ACT ACT ACT ACT ACT ES GBM/ACT  ES ES ACT	- - - - - - - - - - - -	2700 2700 2700 2700 2700 2700 2700 2700	- - - - - - - - - - - -	REFER TO INTERIOR ELEVATIONS FOR EXTENT OF CT  REFER TO INTERIOR ELEVATIONS FOR EXTENT OF CT  REFER TO INTERIOR ELEVATIONS FOR

### MATERIALS LEGEND

- ACT ACOUSTIC CEILING TILE CB CONCRETE BLOCK
- EC EXPOSED CONCRETE EP EPOXY FINISH
- ES EXPOSED STRUCTURE
- PT PAINT SC SEALED CONCRETE
- GB GYPSUM BOARD GBM MOISTURE RESISTANT GYPSUM BOARD
- VT VINYL TILE CT CERAMIC TILE
- RB RUBBER BASE
- AP ACOUSTIC PANEL

- NOTE:
- FINISHES AFTER INSTALLATION OF ALL EQUIPMENT AND SERVICES. 2. DO NOT PAINT PORTIONS OF WALL THAT ARE ADJACENT TO TANKS OR CHANNELS.

1. FLOOR AND WALL FINISH TO BE COMPLETED PRIOR TO EQUIPMENT AND

SERVICES INSTALLATION. CONTRACTOR TO PATCH AND MAKE PROPER

				DOO	R & FI	RAME	E SCH	EDUL	Ε			
			D	OOR				FRAME		<u>o</u>		T
Building	DOOR NUMBER	LOCATION	DOOR SIZE	TYPE	MATERIAL	FINISH	TYPE	MATERIAL	FINISH	FIRE RATING	HARDWARE GROUP	REMARKS
EADWORKS BUILDING	D201	SCREEN AND DEGRIT ROOM	1050 x 2135 x 45	DE2	IHM	PT	FE2	PS	PT	1.5H	GROUP 14	
EADWORKS BUILDING	D202	ELECTRICAL ROOM	1200 x 3100 x 45	DE9	IHM	PT	FE2	PS	PT	1.5H	GROUP 14	DOOR WITH REMOVABLE TRANSOM
EADWORKS BUILDING	D203	MECHANICAL ROOM	2 - 915 x 2135 x 45	DE4	IHM	PT	FE4	PS	PT	-	GROUP 2A	DOOR WITH LOUVER TRANSOM, REFER TO MECHANICAL
EADWORKS BUILDING	D204	SCREENINGS BIN AREA	3048 x 3200	DE7	IHM	PT	_	PS	PT	_	-	
EADWORKS BUILDING	D205	SCREENINGS BIN AREA	915 x 2135 x 45	DE2	IHM	PT	FE4	PS	PT	_	GROUP 1	
UNNEL	D301	PROCESS BUILDING BASEMENT	1050 x 2135 x 45	DE2	HM	PT	FE2	PS	PT	45 MIN	GROUP 15	
IV BUILDING	D501	EXIT STAIRS	915 x 2135 x 45	DE1	IHM	PT	FE4	PS	PT	1.5H	GROUP 14	
V BUILDING	D502	UV DISINFECTION CHANNEL	2 - 915 x 3135 x 45	DE10	IHM	PT	FE2	PS	PT	-	GROUP 2A	DOOR WITH REMOVABLE TRANSOM
V BUILDING	D503	ELECTRICAL ROOM	1200 x 3135 x 45	DE9	IHM	PT	FE2	PS	PT	_	GROUP 1	DOOR WITH REMOVABLE TRANSOM
V BUILDING	D504	EXIT STAIRS	1050 x 2135 x 45	DE1	HM	PT	FE2	PS	PT	45 MIN	GROUP 15	
V BUILDING	D505	MECHANICAL ROOM	1050 x 2135 x 45	DE2	HM	PT	FE2	PS	PT	-	GROUP 16	
V BUILDING	D506	EXIT STAIRS BASEMENT	1050 x 2135 x 45	DE2	HM	PT	FE2	PS	PT	1.5H	GROUP 15	
V BUILDING	D507	BASEMENT TUNNEL	1050 x 2135 x 45	DE1	HM	PT	FE2	PS	PT	1.5H	GROUP 5	
ROCESS BUILDING	D601	CHEMICAL ROOM	915 x 2135 x 45	DE2	IHM	PT	FE4	PS	PT	-	GROUP 1	
ROCESS BUILDING	D602	EXIT STAIRS GROUND FLOOR	915 x 2135 x 45	DE1	IHM	PT	FE4	PS	PT	_	GROUP 1	
ROCESS BUILDING	D603	BLOWER ROOM	2 - 1200 x 2615 x 45	DE3	IHM	PT	FE5	PS	PT	_	GROUP 2A	DOOR WITH LOUVER TRANSOM. REFER TO MECHANICAL
ROCESS BUILDING	D604	ELECTRICAL ROOM	1200 x 3135 x 45	DE9	IHM	PT	FE2	PS	PT	-	GROUP 1	DOOR WITH REMOVABLE TRANSOM
ROCESS BUILDING	D605	MECHANICAL ROOM	1050 x 2135 x 45	DE2	HM	PT	FE2	PS	PT	_	GROUP 4	
ROCESS BUILDING	D606	MECHANICAL ROOM	2 - 915 x 2135 x 45	DE4	IHM	PT	FE5	PS	PT	-	GROUP 2A	DOOR WITH LOUVER TRANSOM. REFER TO MECHANICAL
ROCESS BUILDING	D607	EXIT STAIRS GROUND FLOOR	915 x 2135 x 45	DE1	HM	PT	FE4	PS	PT	45 MIN	GROUP 15	
ROCESS BUILDING	D608	ELECTRICAL ROOM	1050 x 2135 x 45	DE2	HM	PT	FE2	PS	PT	-	GROUP 4	
ROCESS BUILDING	D609	EXIT STAIRS BASEMENT	1050 x 2135 x 45	DE1	HM	PT	FE2	PS	PT	45 MIN	GROUP 15	
ROCESS BUILDING	D610	EXIT STAIRS BASEMENT	1050 x 2135 x 45	DE1	HM	PT	FE2	PS	PT	45 MIN	GROUP 15	
DMINISTRATION BUILDING		ELECTRICAL ROOM	1050 x 2735 x 45	DE9	IHM	PT	FE2	PS	PT	-	GROUP 1	DOOR WITH REMOVABLE TRANSOM
DMINISTRATION BUILDING		CORRIDOR	1050 x 2135 x 45	DE2	IHM	PT	FE2	PS	PT	_	GROUP 1	
DMINISTRATION BUILDING		VESTIBULE	1050 x 2150 x 45	DE8	AN	-	FE3	AN	-	_	GROUP 10	
DMINISTRATION BUILDING		LAUNDRY ROOM	1050 x 2135 x 45	DE2	HM	PT	FE2	PS	PT	_	GROUP 4	
DMINISTRATION BUILDING		LUNCH ROOM	1050 x 2135 x 45	DE1	HM	PT	FE3	PS	PT	_	GROUP 4	
DMINISTRATION BUILDING		OFFICE	1050 x 2135 x 45	DE1	HM	PT	FE3	PS	PT	_	GROUP 3	
DMINISTRATION BUILDING		LABORATORY	1050 x 2135 x 45	DE1	HM	PT	FE3	PS	PT	_	GROUP 3	
DMINISTRATION BUILDING		UNIVERSAL WASHROOM	1050 x 2135 x 45	DE5	HM	PT	FE1	PS	PT	-	GROUP 8	DOOR GRILLE. REFER TO MECHANICAL
DMINISTRATION BUILDING		DOCUMENT ROOM	1050 x 2135 x 45	DE6	HM	PT	FE1	PS	PT	-	GROUP 16	
DMINISTRATION BUILDING		MENS WASHROOM	1050 x 2135 x 45	DE5	HM	PT	FE1	PS	PT	-	GROUP 7	DOOR GRILLE. REFER TO MECHANICAL
DMINISTRATION BUILDING		JANITORS CLOSET	915 x 2135 x 45	DE5	HM	PT	FE1	PS	PT	45 MIN	GROUP 5	DOOR GRILLE. REFER TO MECHANICAL
DMINISTRATION BUILDING		WOMENS WASHROOM	1050 x 2135 x 45	DE5	НМ	PT	FE1	PS	PT	-	GROUP 7	DOOR GRILLE. REFER TO MECHANICAL
DMINISTRATION BUILDING		MECHANICAL ROOM	1050 x 2135 x 45	DE2	HM	PT	FE2	PS	PT	-	GROUP 16	
DMINISTRATION BUILDING		VESTIBULE	1050 x 2150 x 45	DE8	AN	-	FE3	AN	-	-	GROUP 9	
DMINISTRATION BUILDING		SCADA ROOM	1050 x 2135 x 45	DE1	НМ	PT	FE3	PS	PT	-	GROUP 3	
DMINISTRATION BUILDING		CLOSET	915 x 2135 x 45	DE5	HM	PT	FE1	PS	PT	-	GROUP 16	
DMINISTRATION BUILDING		CONTROL ROOM	1050 x 2135 x 45	DE1	HM	PT	FE3	PS	PT	-	GROUP 3	
DMINISTRATION BUILDING		CORRIDOR	1050 x 2135 x 45	DE2	IHM	PT	FE2	PS	PT	<u> </u>	GROUP 1	


## DOOR LEGEND

- HM HOLLOW METAL DOOR IHM INSULATED HOLLOW METAL DOOR
- PT PAINT
- PS PRESSED STEEL
  AN ANODIZED ALUMINIUM

WINDOW SCHEDULE												
WINDOW No.	WIDTH	HEIGHT	QUANTITY	FRAME TYPE	FRAME MATERIAL	SILL HEIGTH	COMMENTS					
GL1	1100	1200	8	AN	AN	REFER TO ELEVATIONS						
GL2	2000	1200	1	AN	AN	1000	-					


# WINDOW LEGEND

AN ANODIZED ALUMINIUM

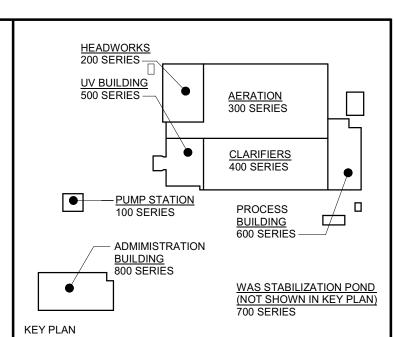

DESIGN DOCUMENTS HEREIN HAVE BEEN DESIGNED UNDER THE ONTARIO **BUILDING CODE 2012.** 

(NOT TO SCALE)

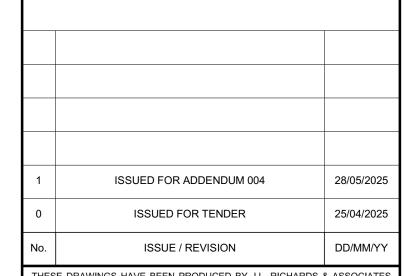

THESE DRAWINGS HAVE BEEN PRODUCED BY J.L. RICHARDS & ASSOCIATES LIMITED AND ARE SUBJECT TO COPYRIGHT AND USE RESTRICTIONS SET OUT IN THE APPLICABLE PROJECT CONTRACT. ANY USE, REUSE, OR MODIFICATION OF THESE DRAWINGS FOR PURPOSES OTHER THAN THE ORIGINAL PROJECT OR EXECUTION OF THE DESCRIBED WORK IS NOT PERMITTED OR ENDORSE WITHOUT THE PRIOR WRITTEN AUTHORIZATION OF JLR. JLR MAKES NO WARRANTIES, EITHER EXPRESS OR IMPLIED, OF THE SUITABILITY OR FITNESS OF THESE DRAWINGS FOR ANY OTHER PURPOSE, AND ANY PARTY WHICH CHOOSES TO USE, MODIFY, OR OTHERWISE RELY ON THESE DRAWINGS WITHOUT JLR'S AUTHORIZATION ACCEPTS THESE LIMITATIONS AND DOES SO AT THEIR SOLE RISK AND WITHOUT LIABILITY TO JLR.

VERIFY SHEET SIZE AND SCALES. THE BAR TO THE RIGHT IS 25mm IF THIS IS A FULL SIZE DRAWING.

BRIGHTON

STEPHANIE CAMPBELL LICENCE


**BRIGHTON WASTEWATER** TREATMENT SYSTEM UPGRADES


100 COUNTY ROAD 64, BRIGHTON, ONTARIO


ARCHITECTURAL SITE - WIDE


SCHEDULES AND FINISHES


DESIGN:	SC/KA	
DRAWN:	NP	DRAWING #:
CHECKED:	HB/SC	A005
JLR #:	32296-001	

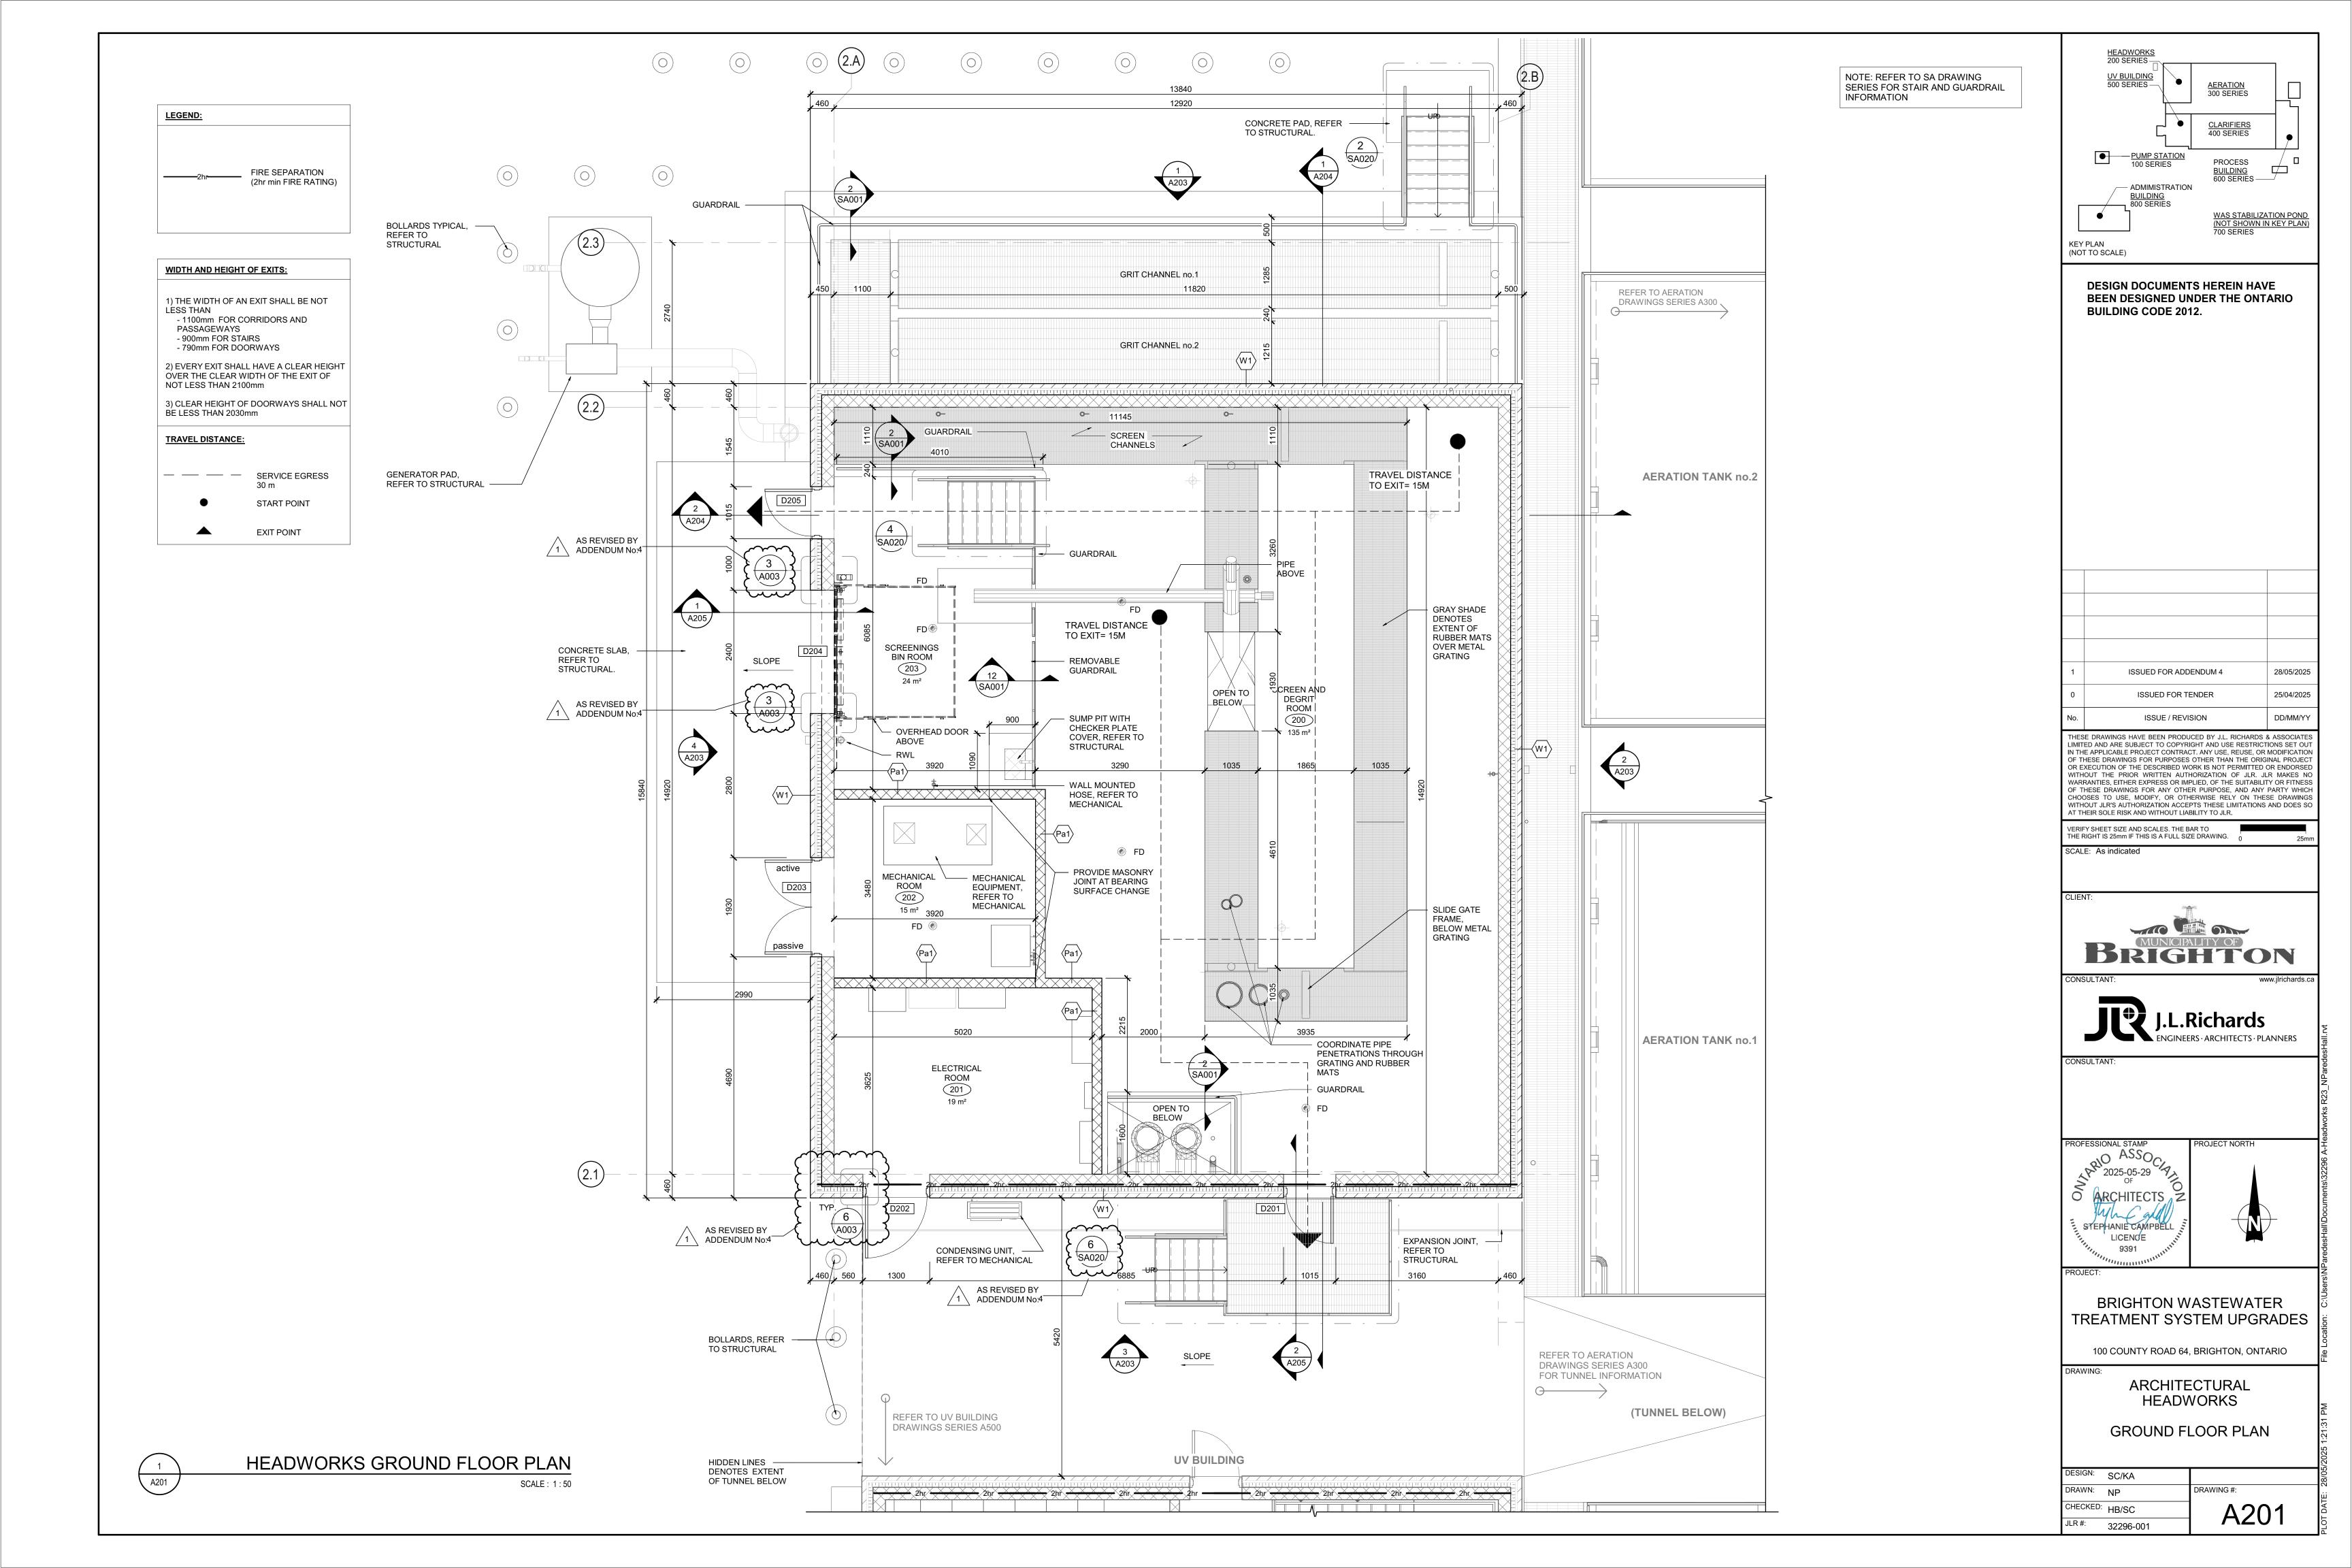


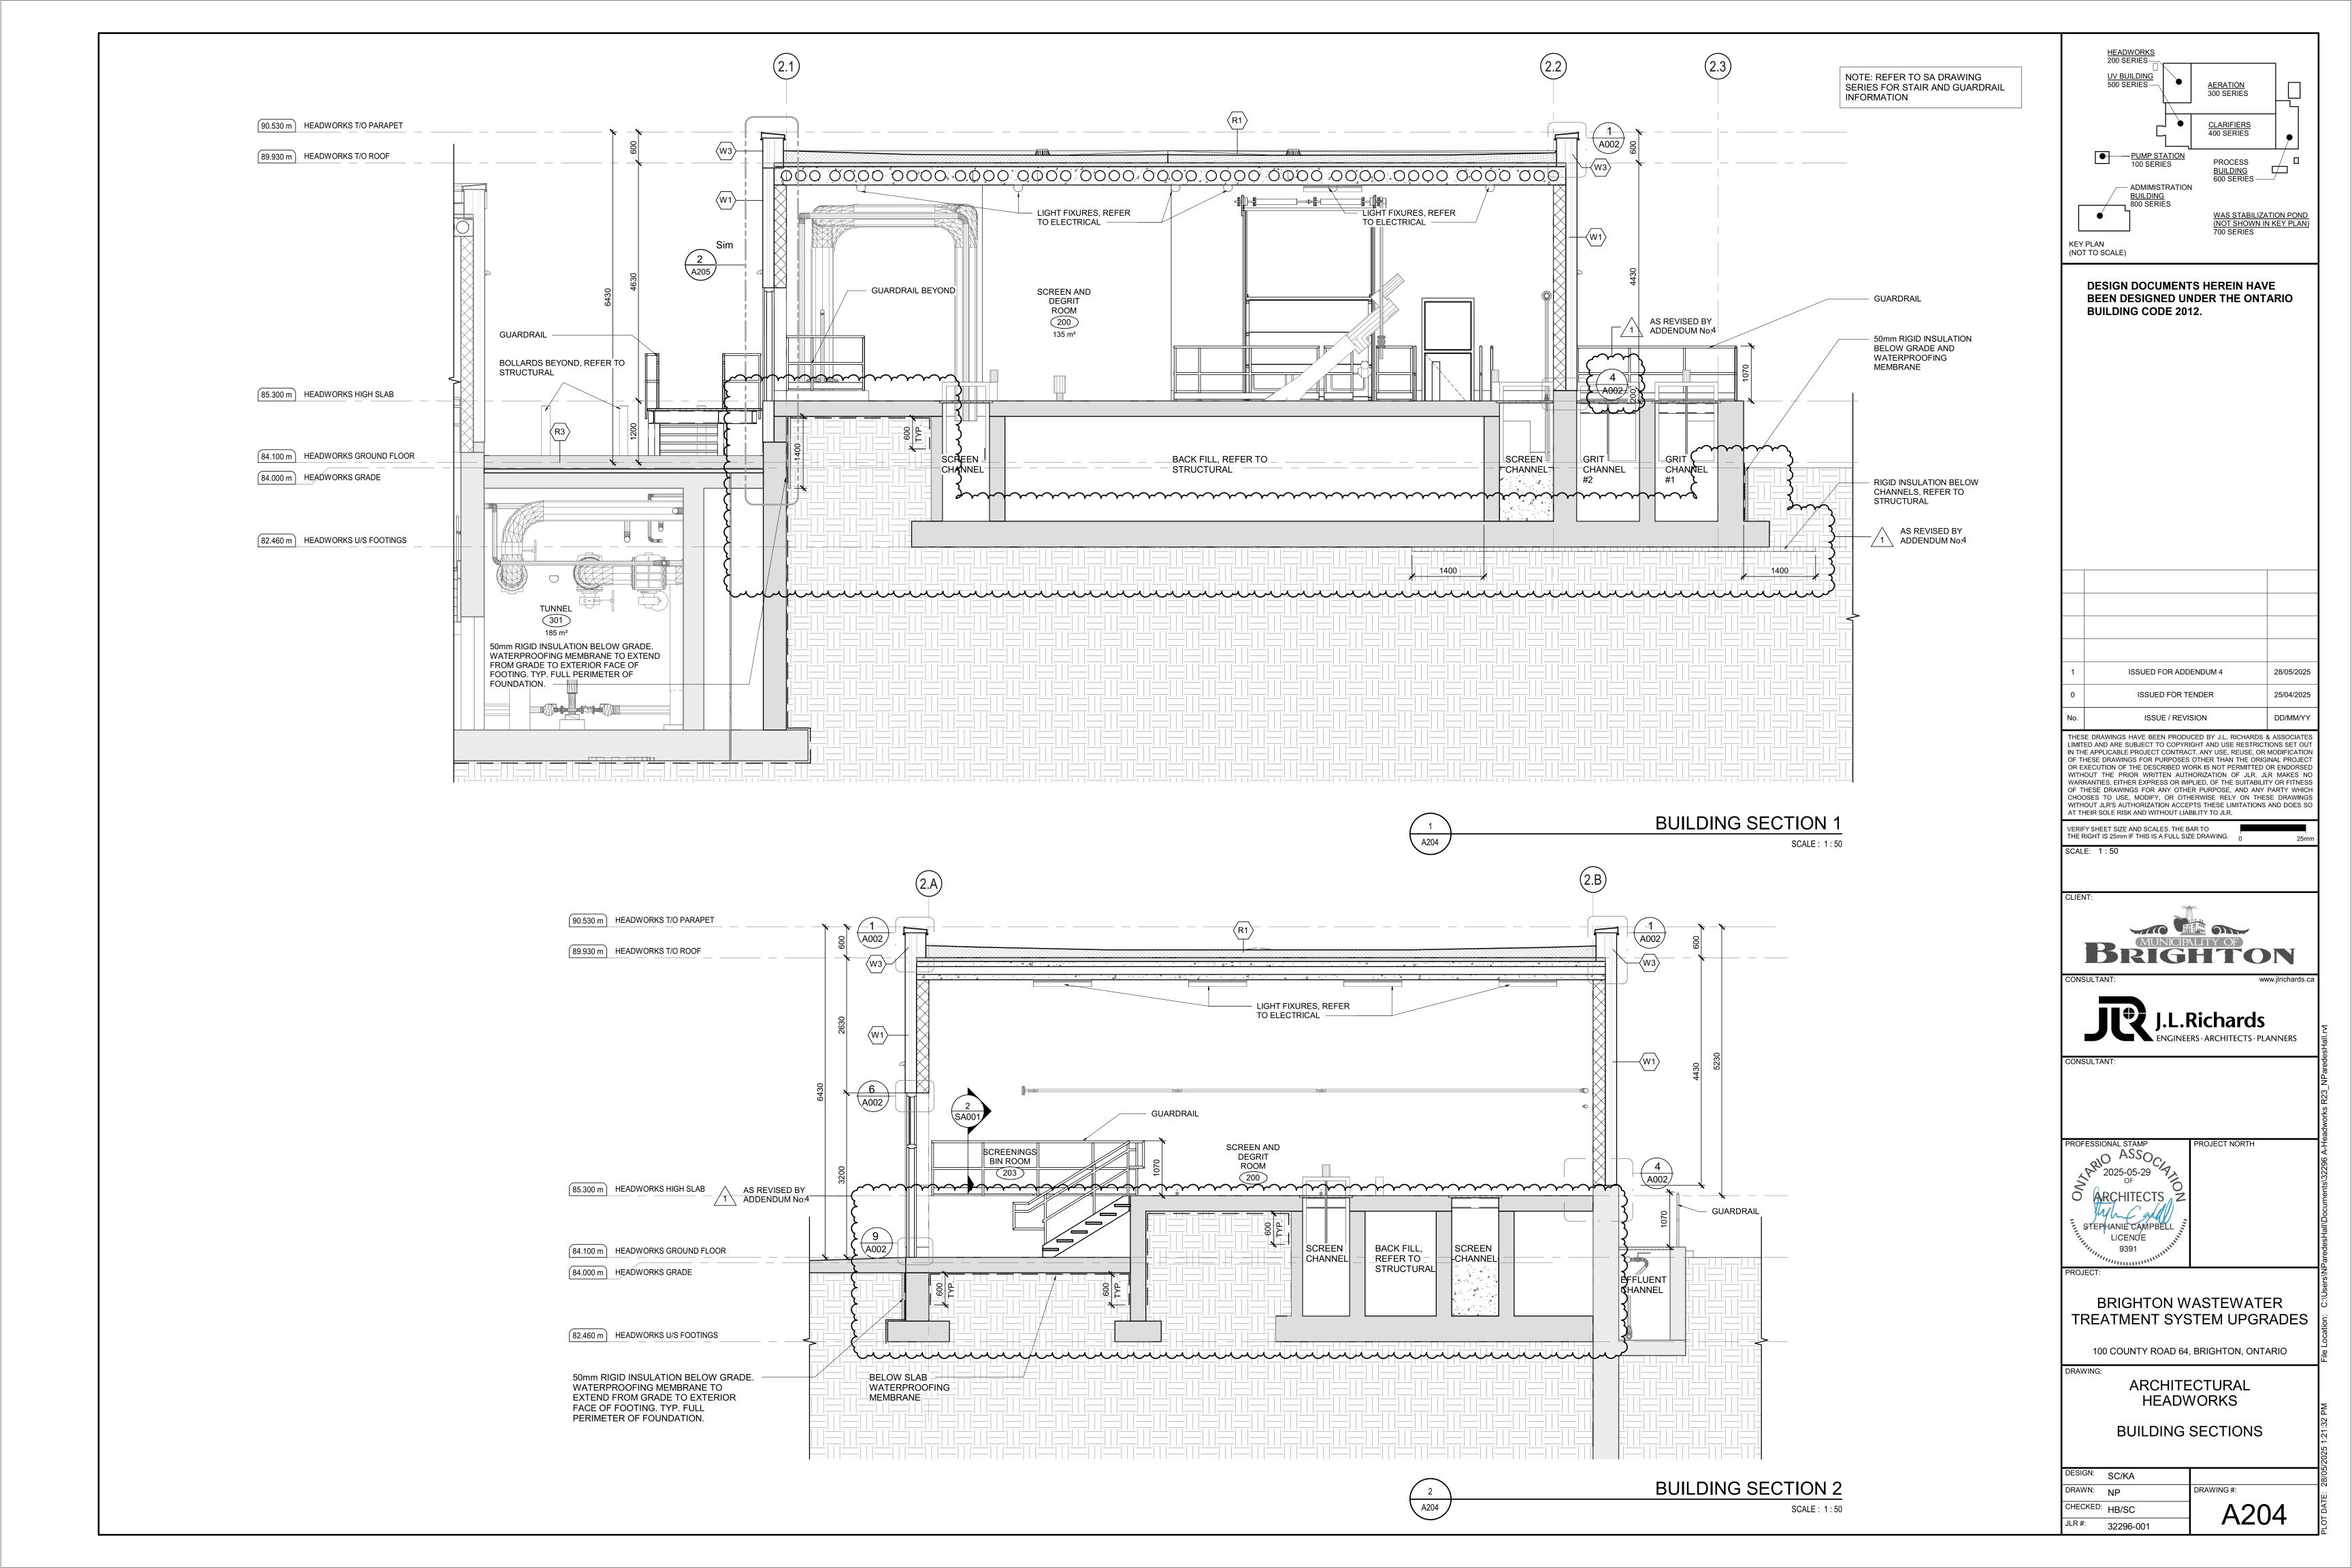


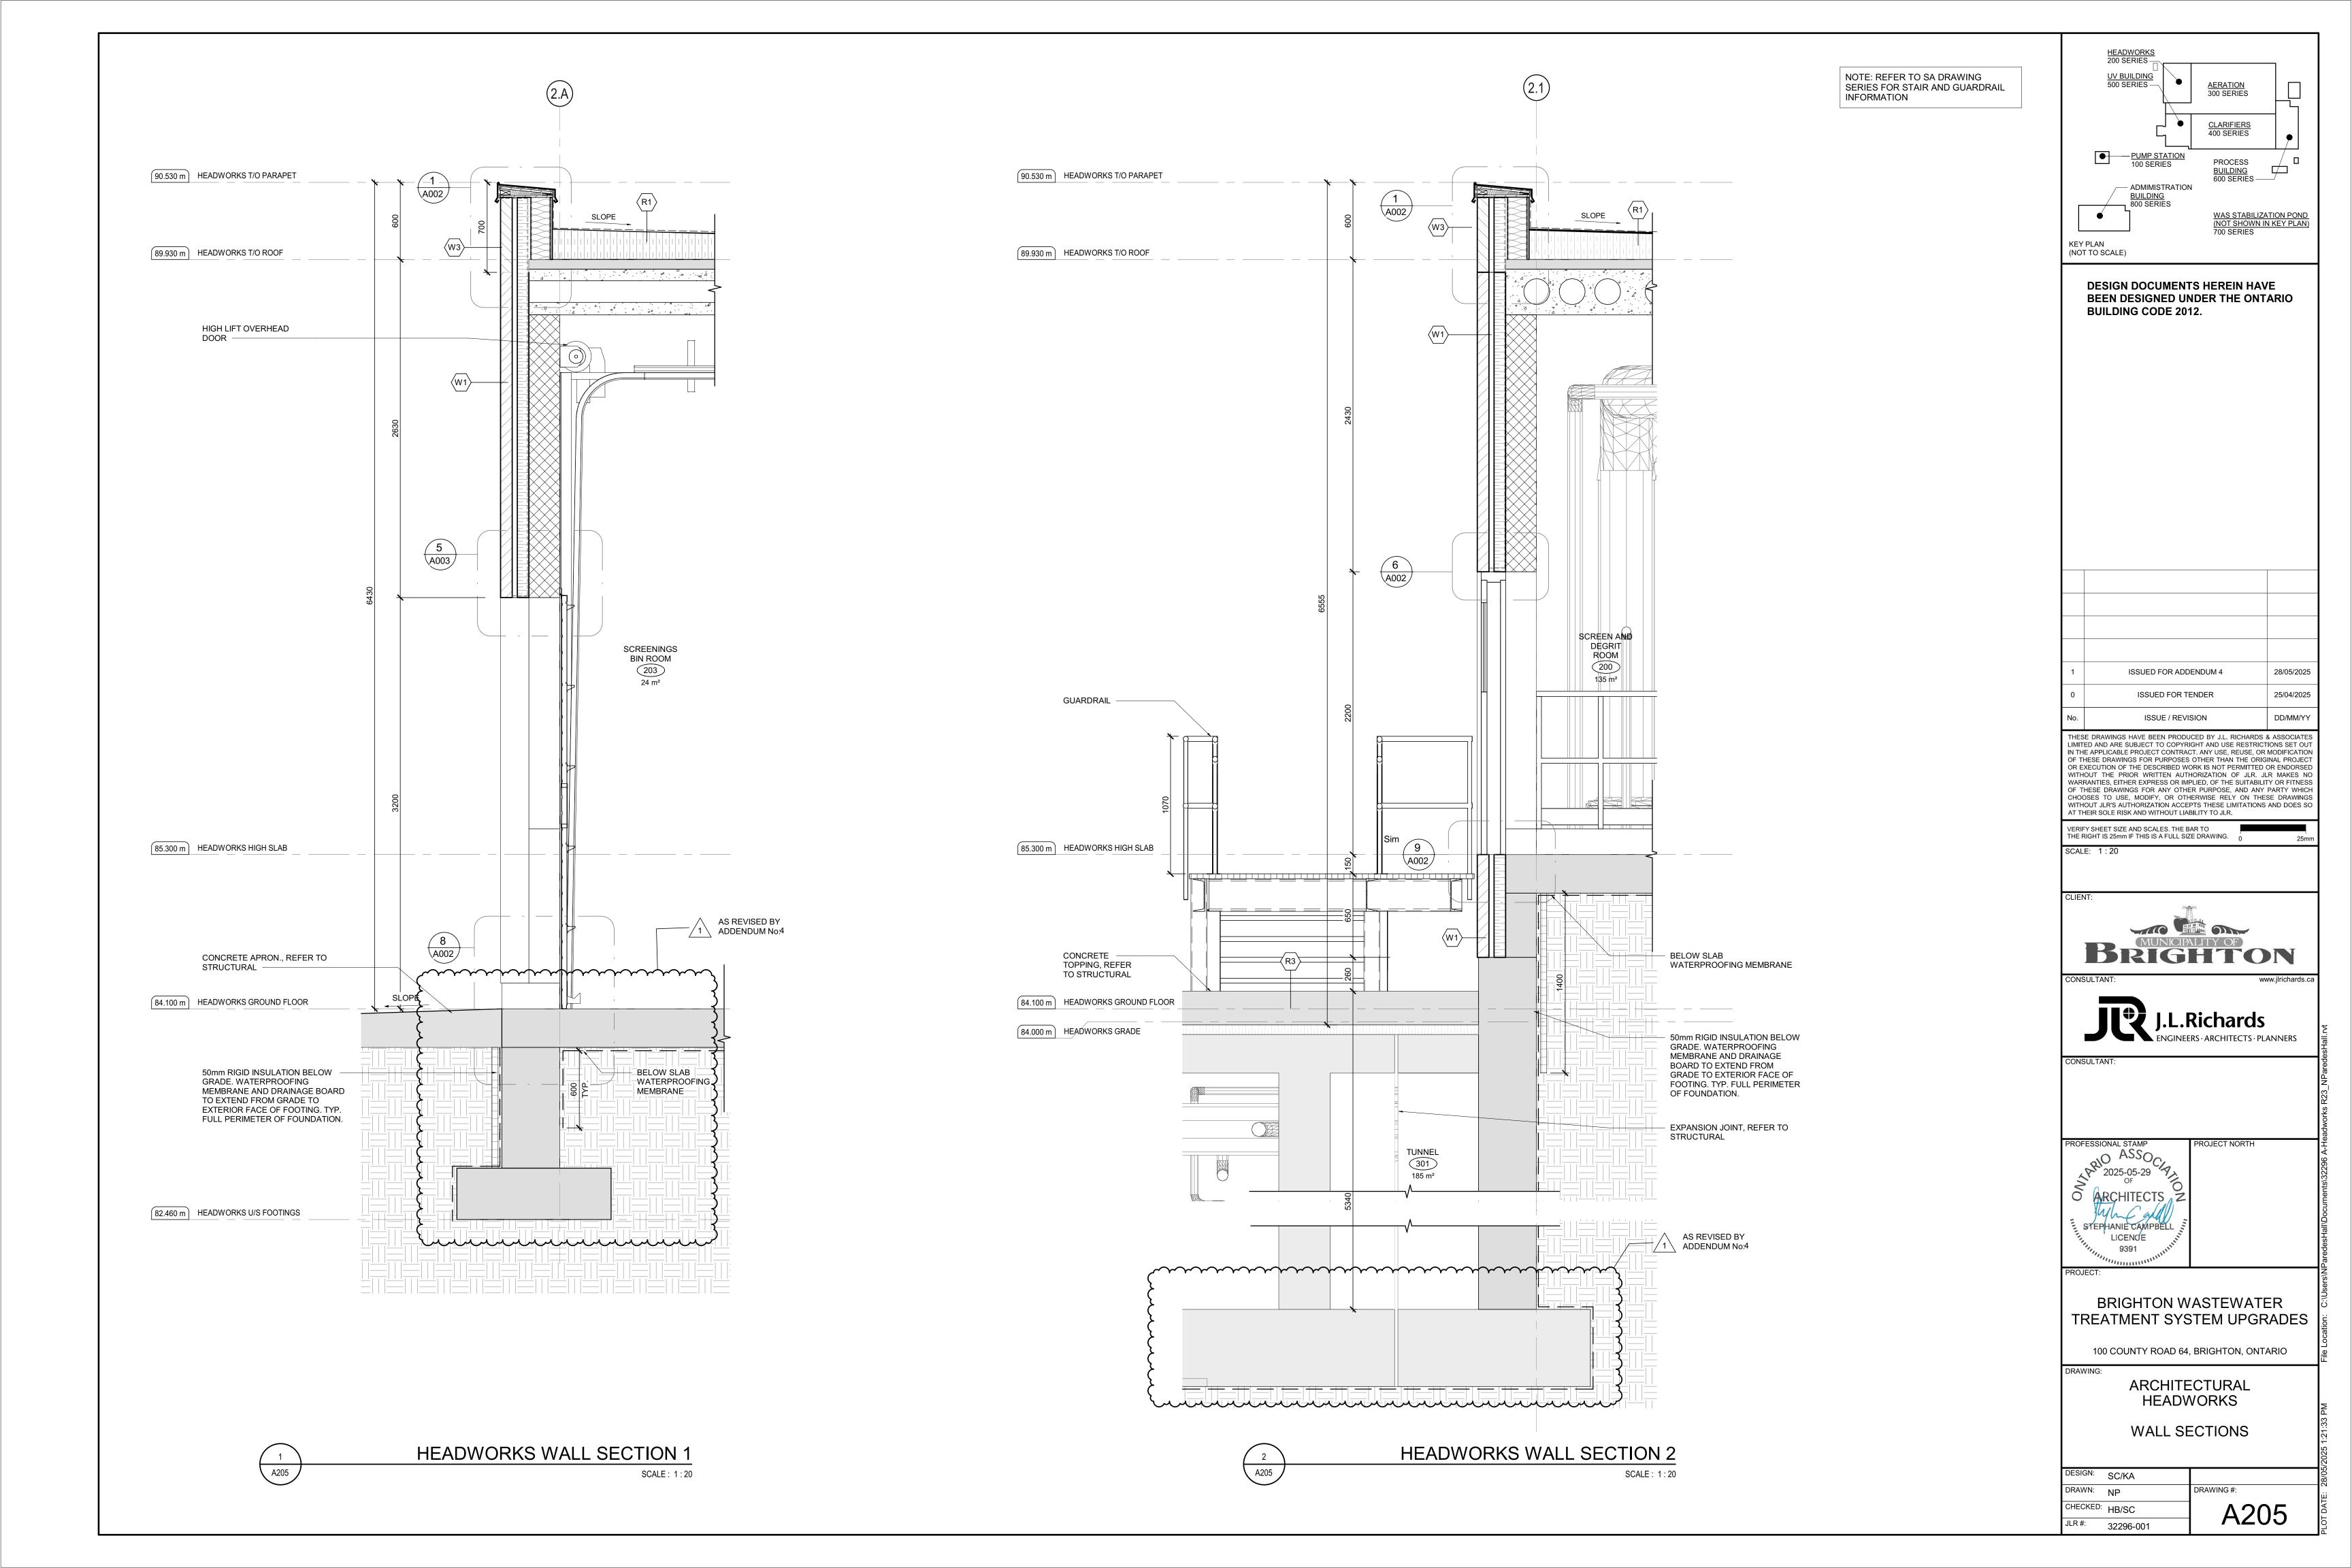

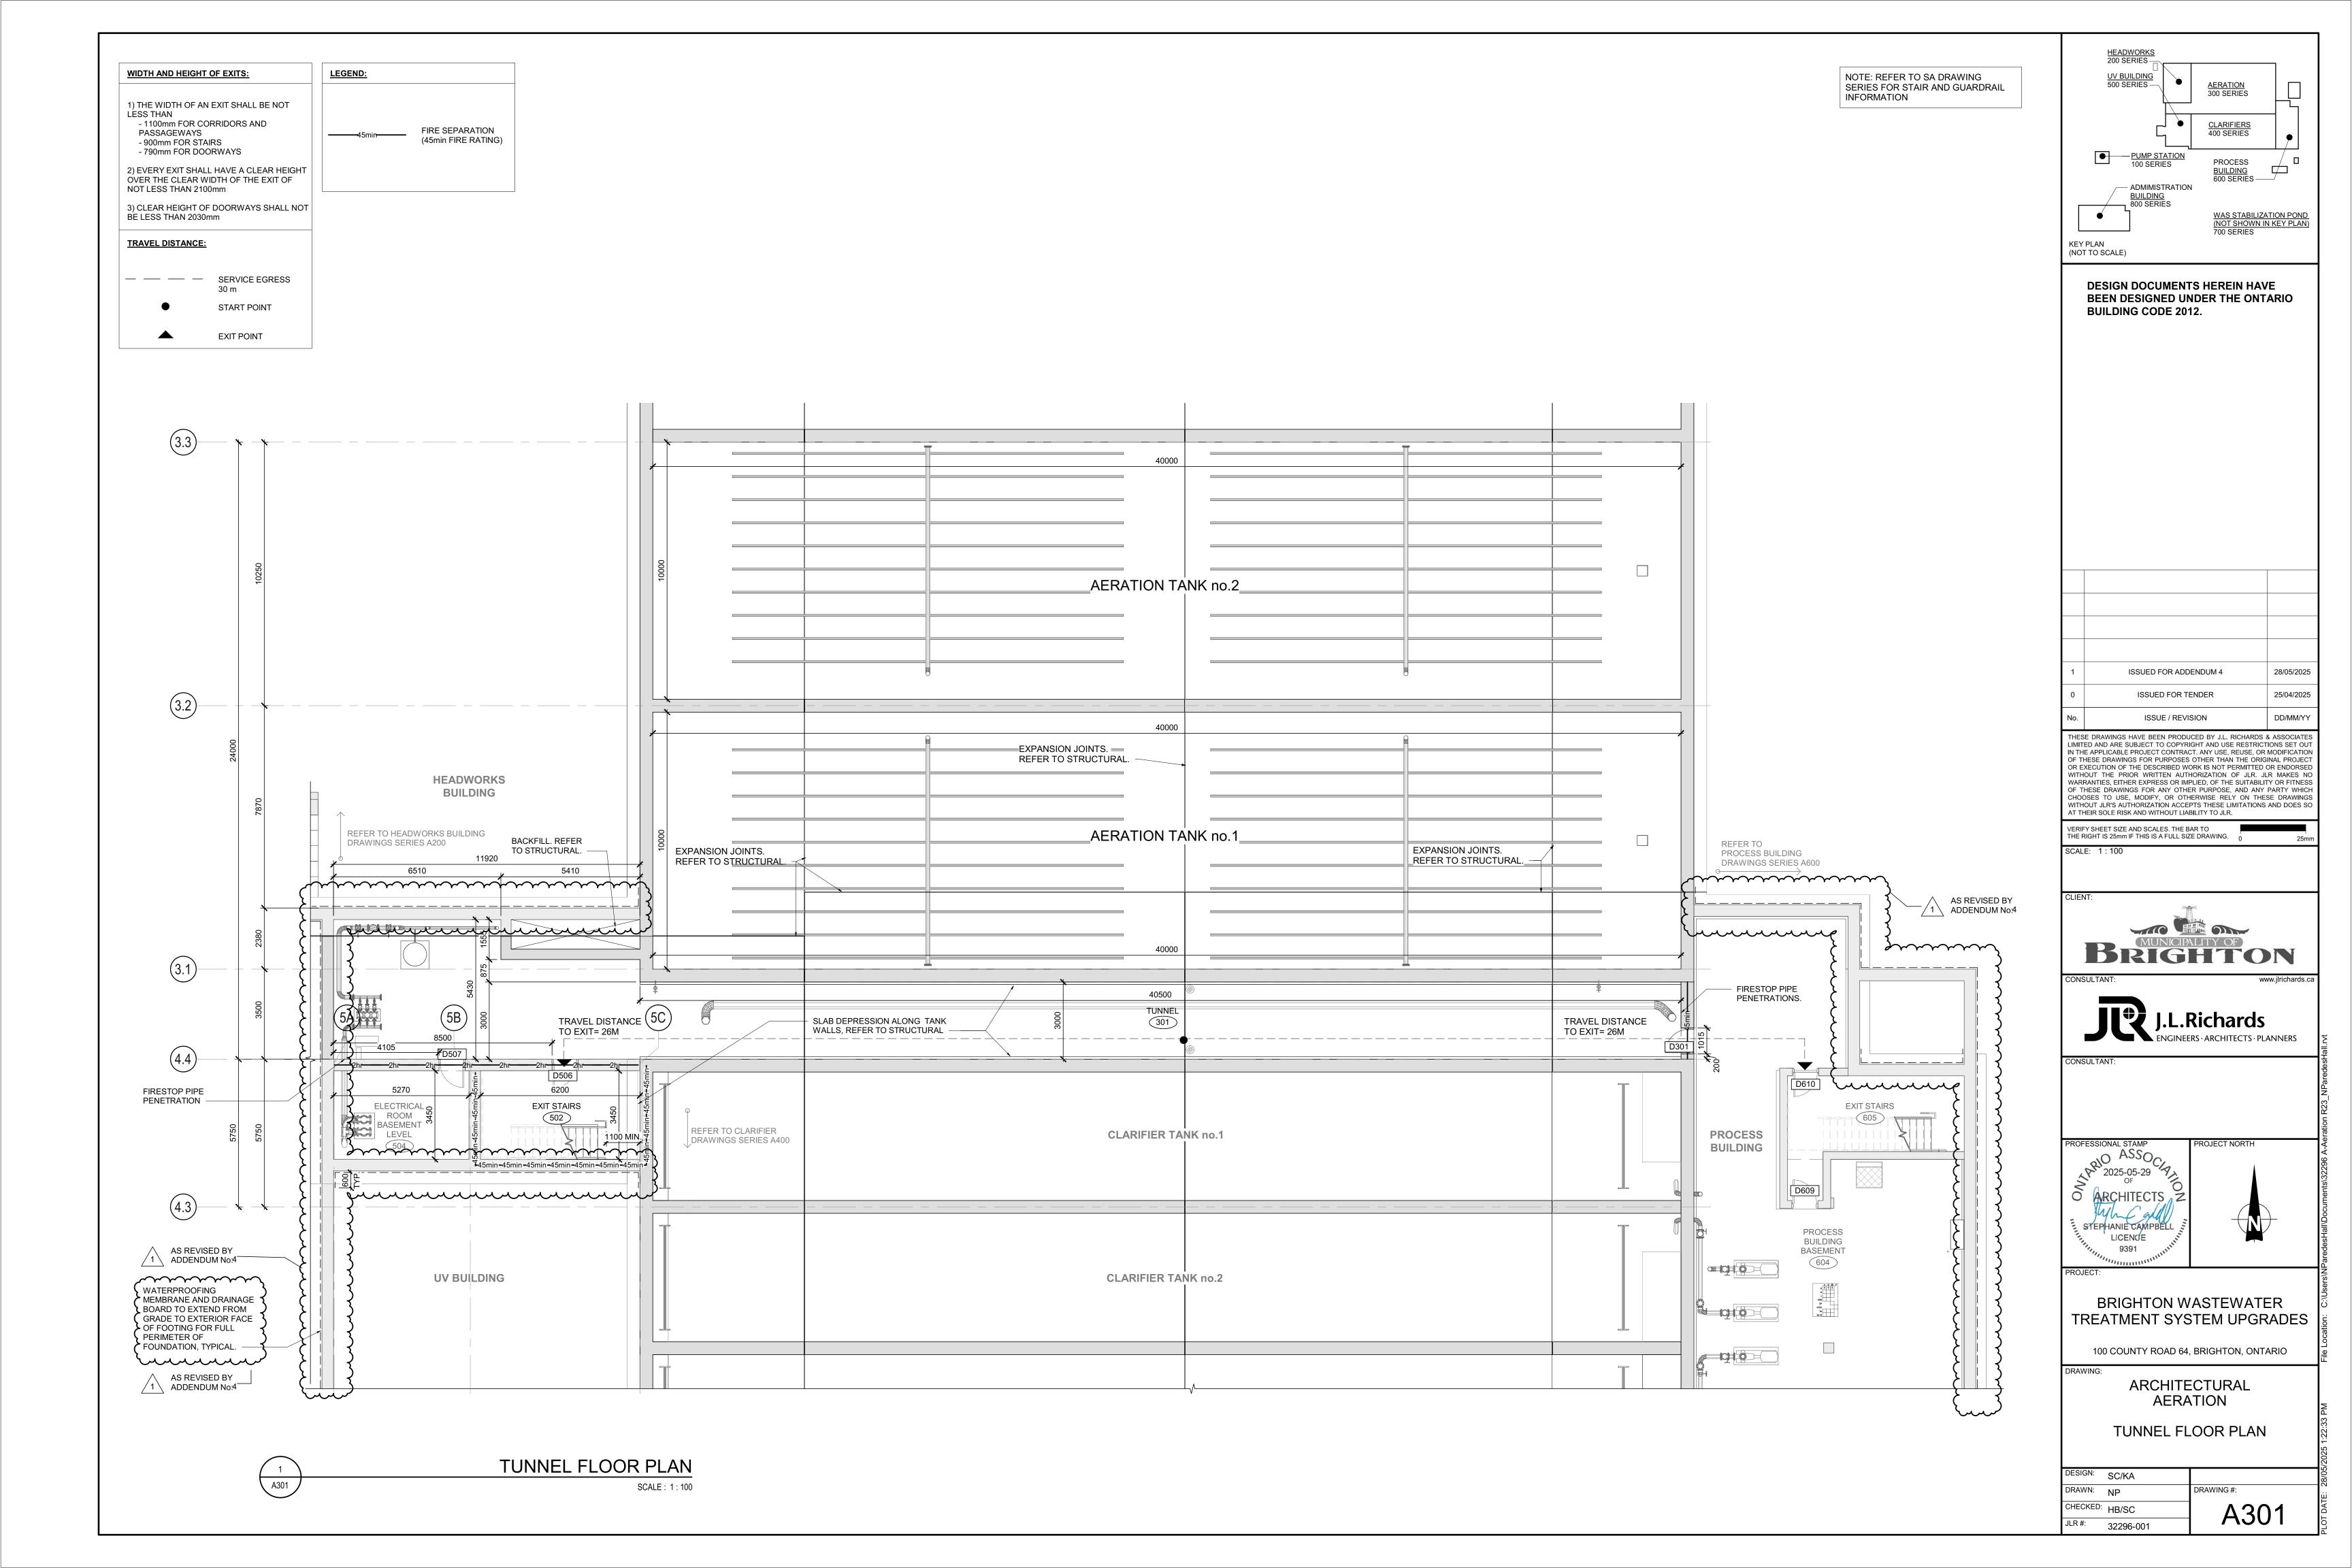

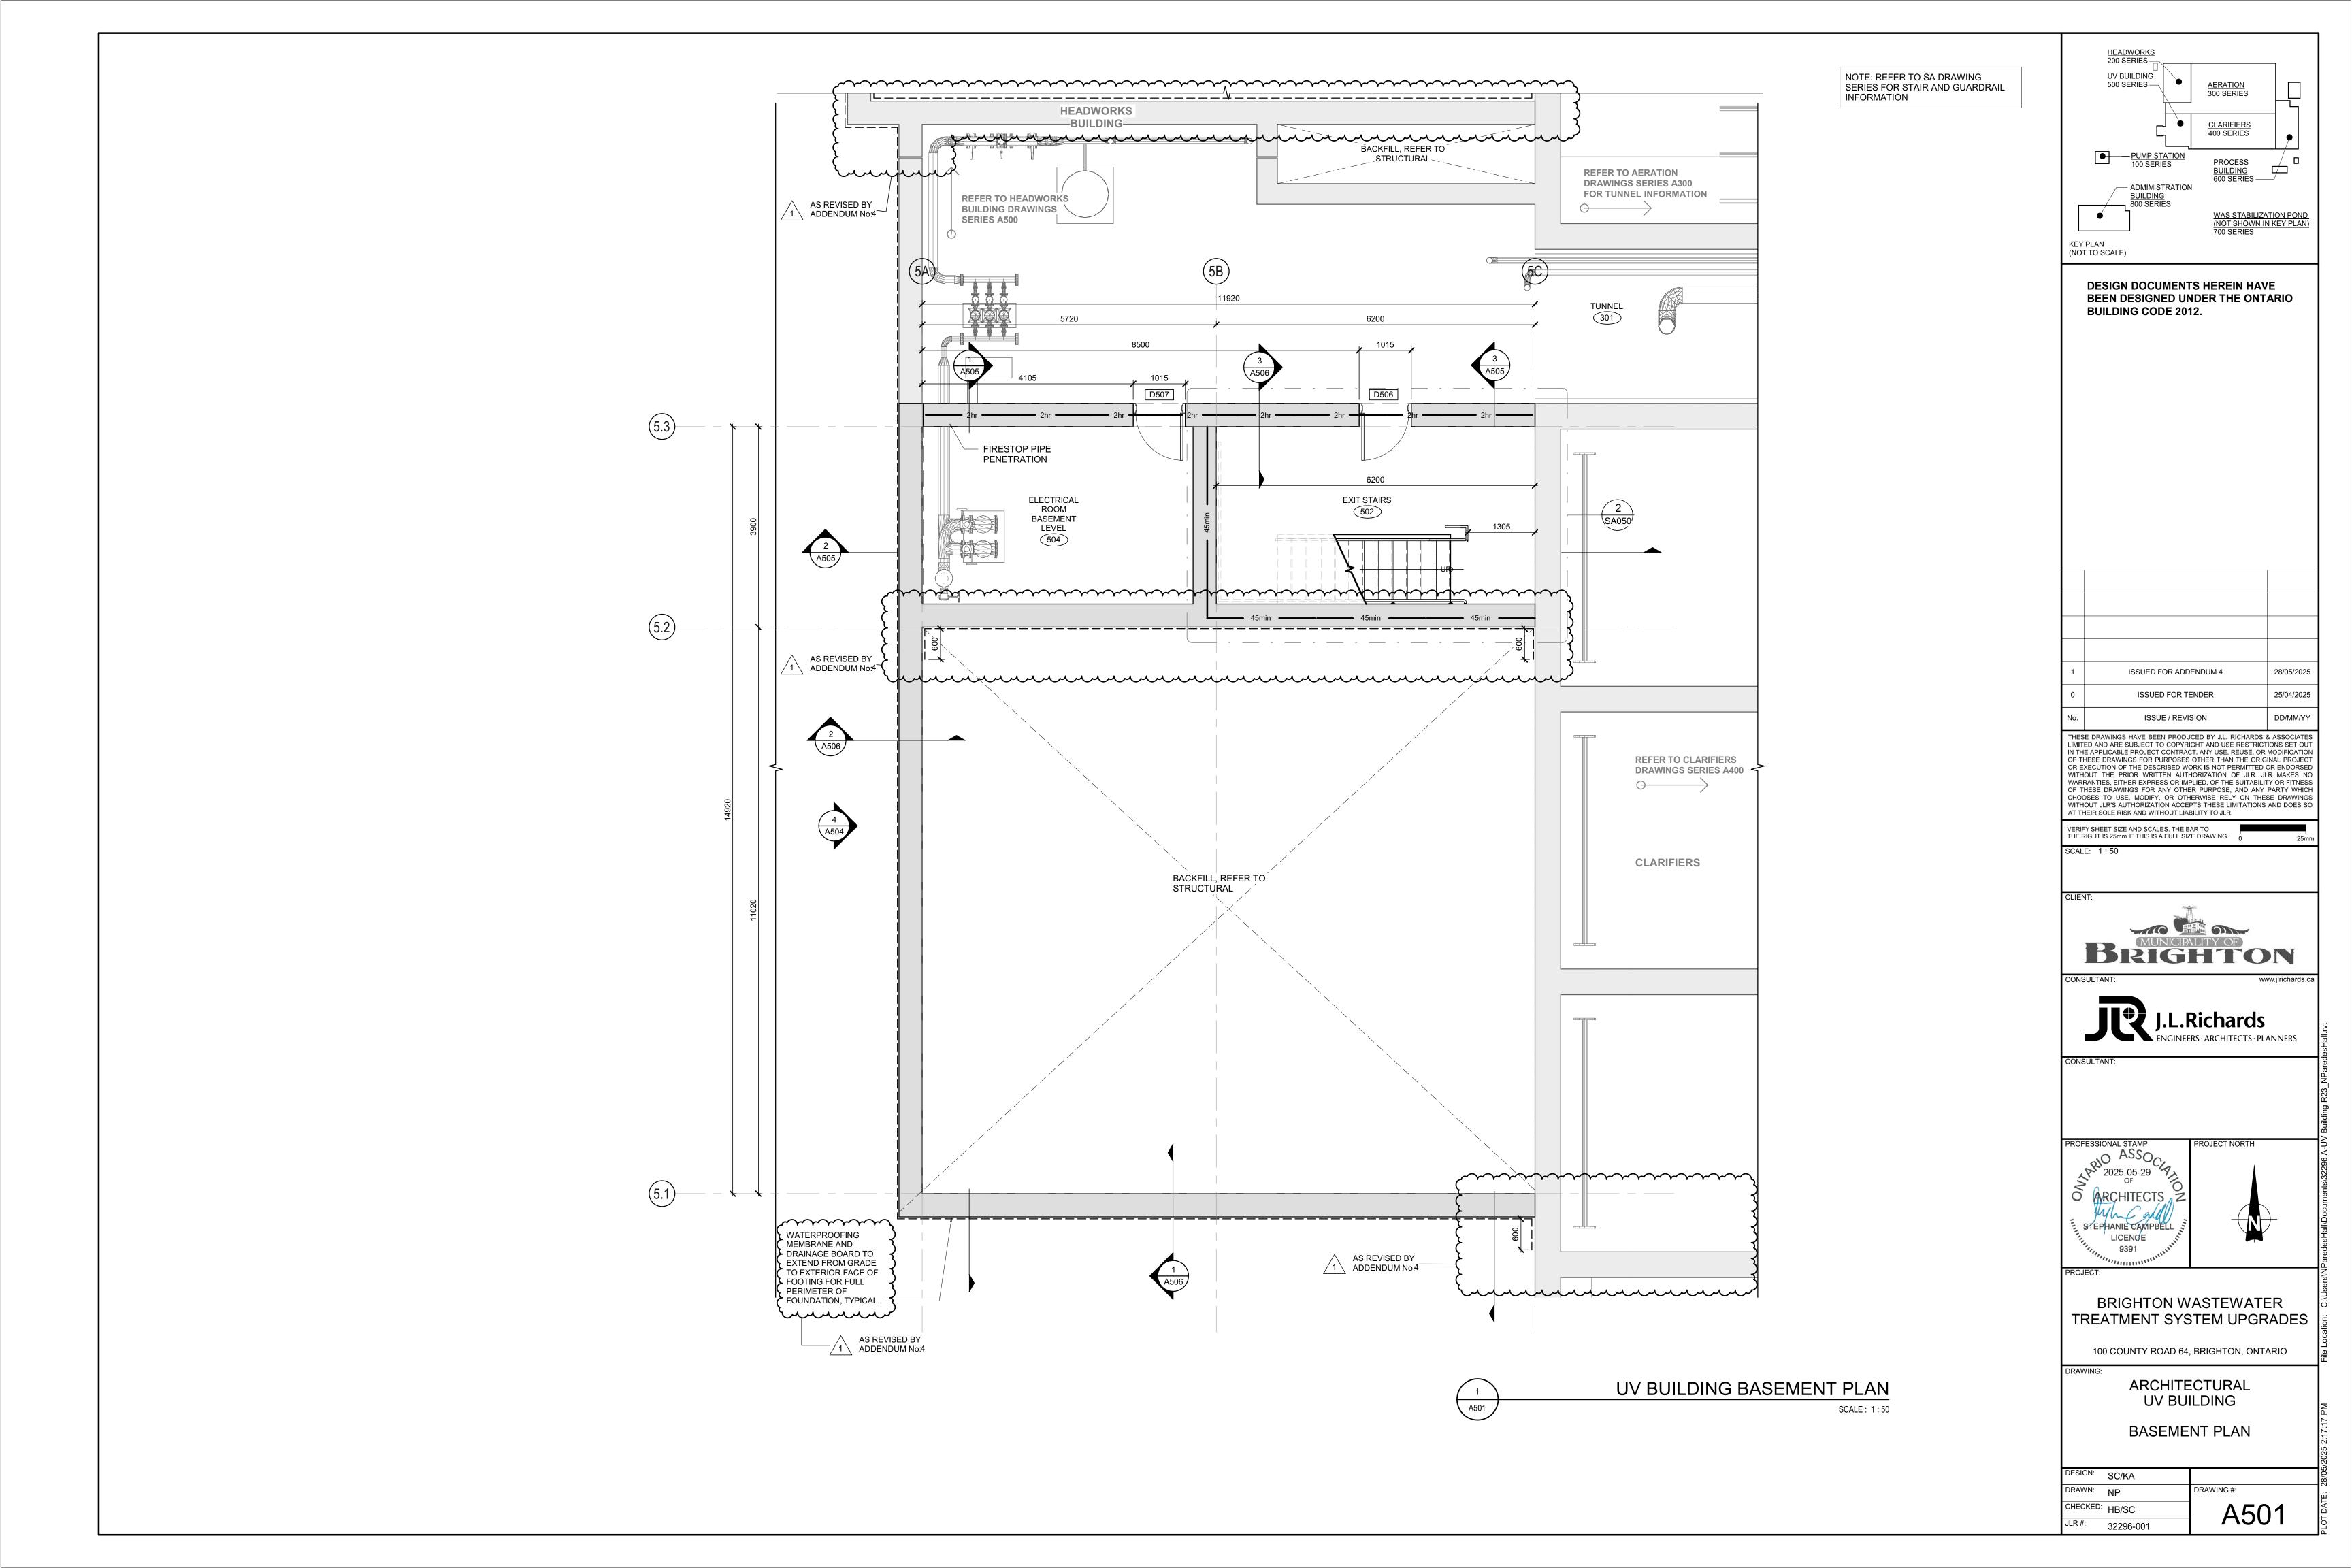

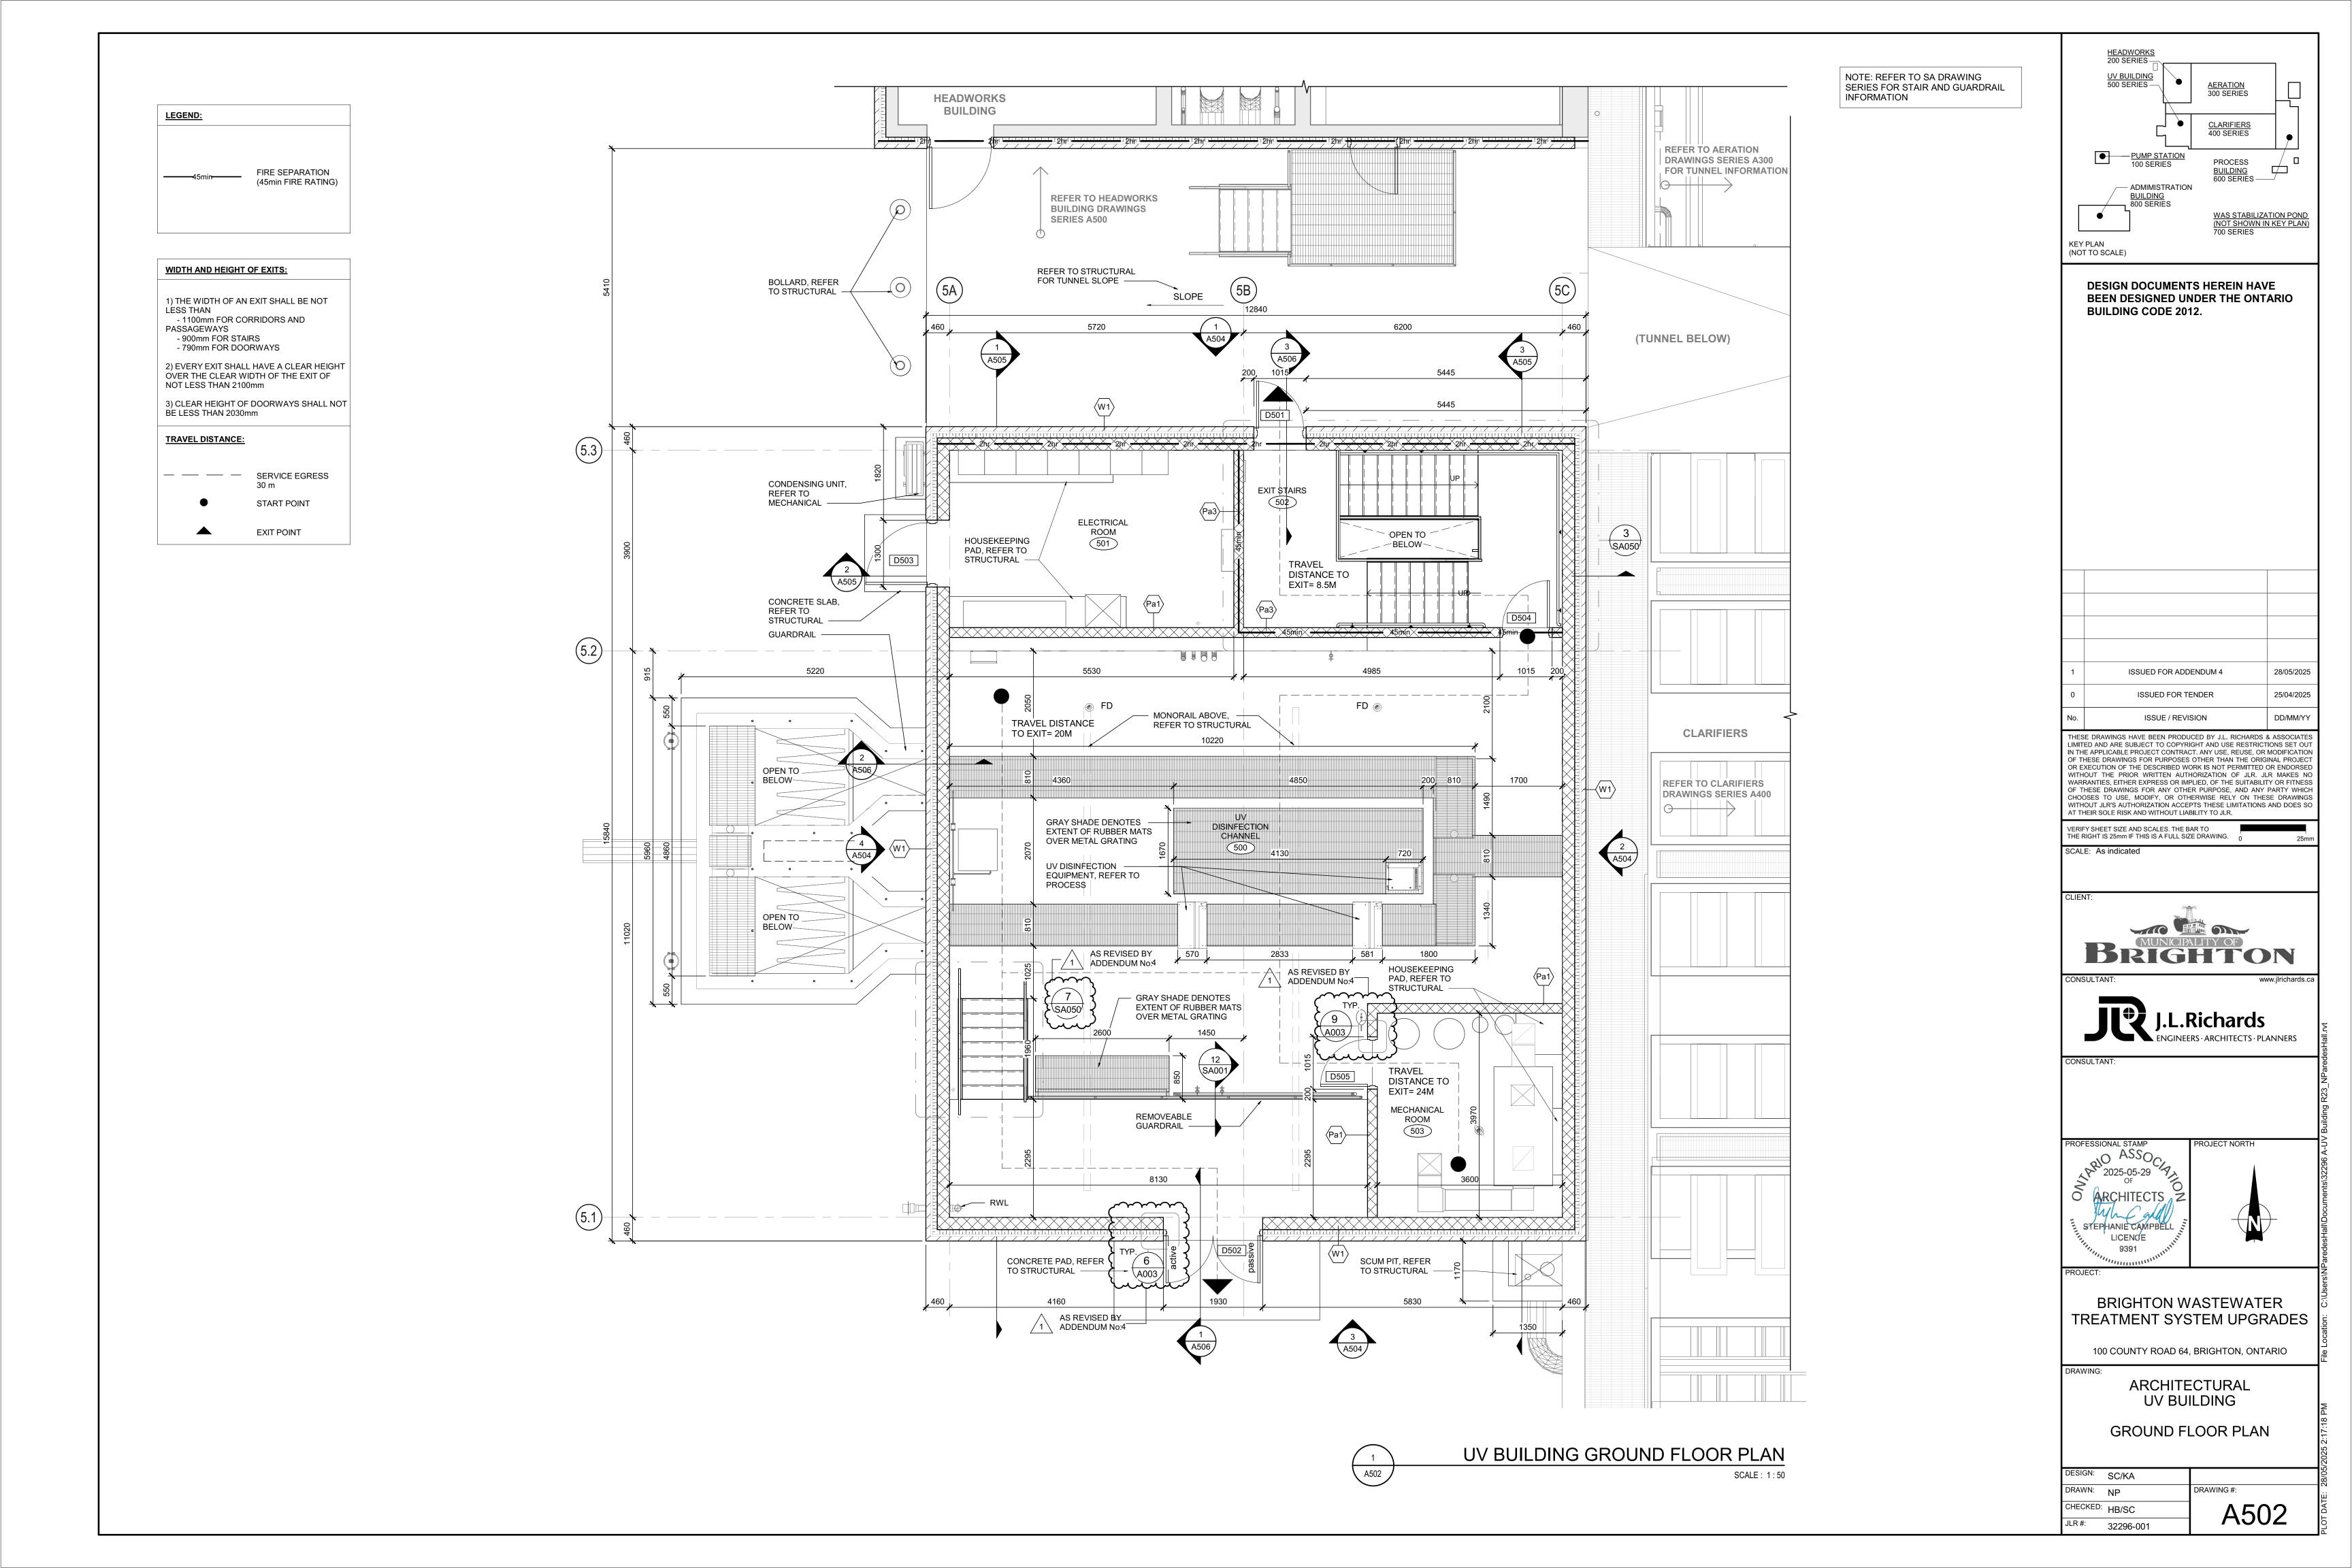

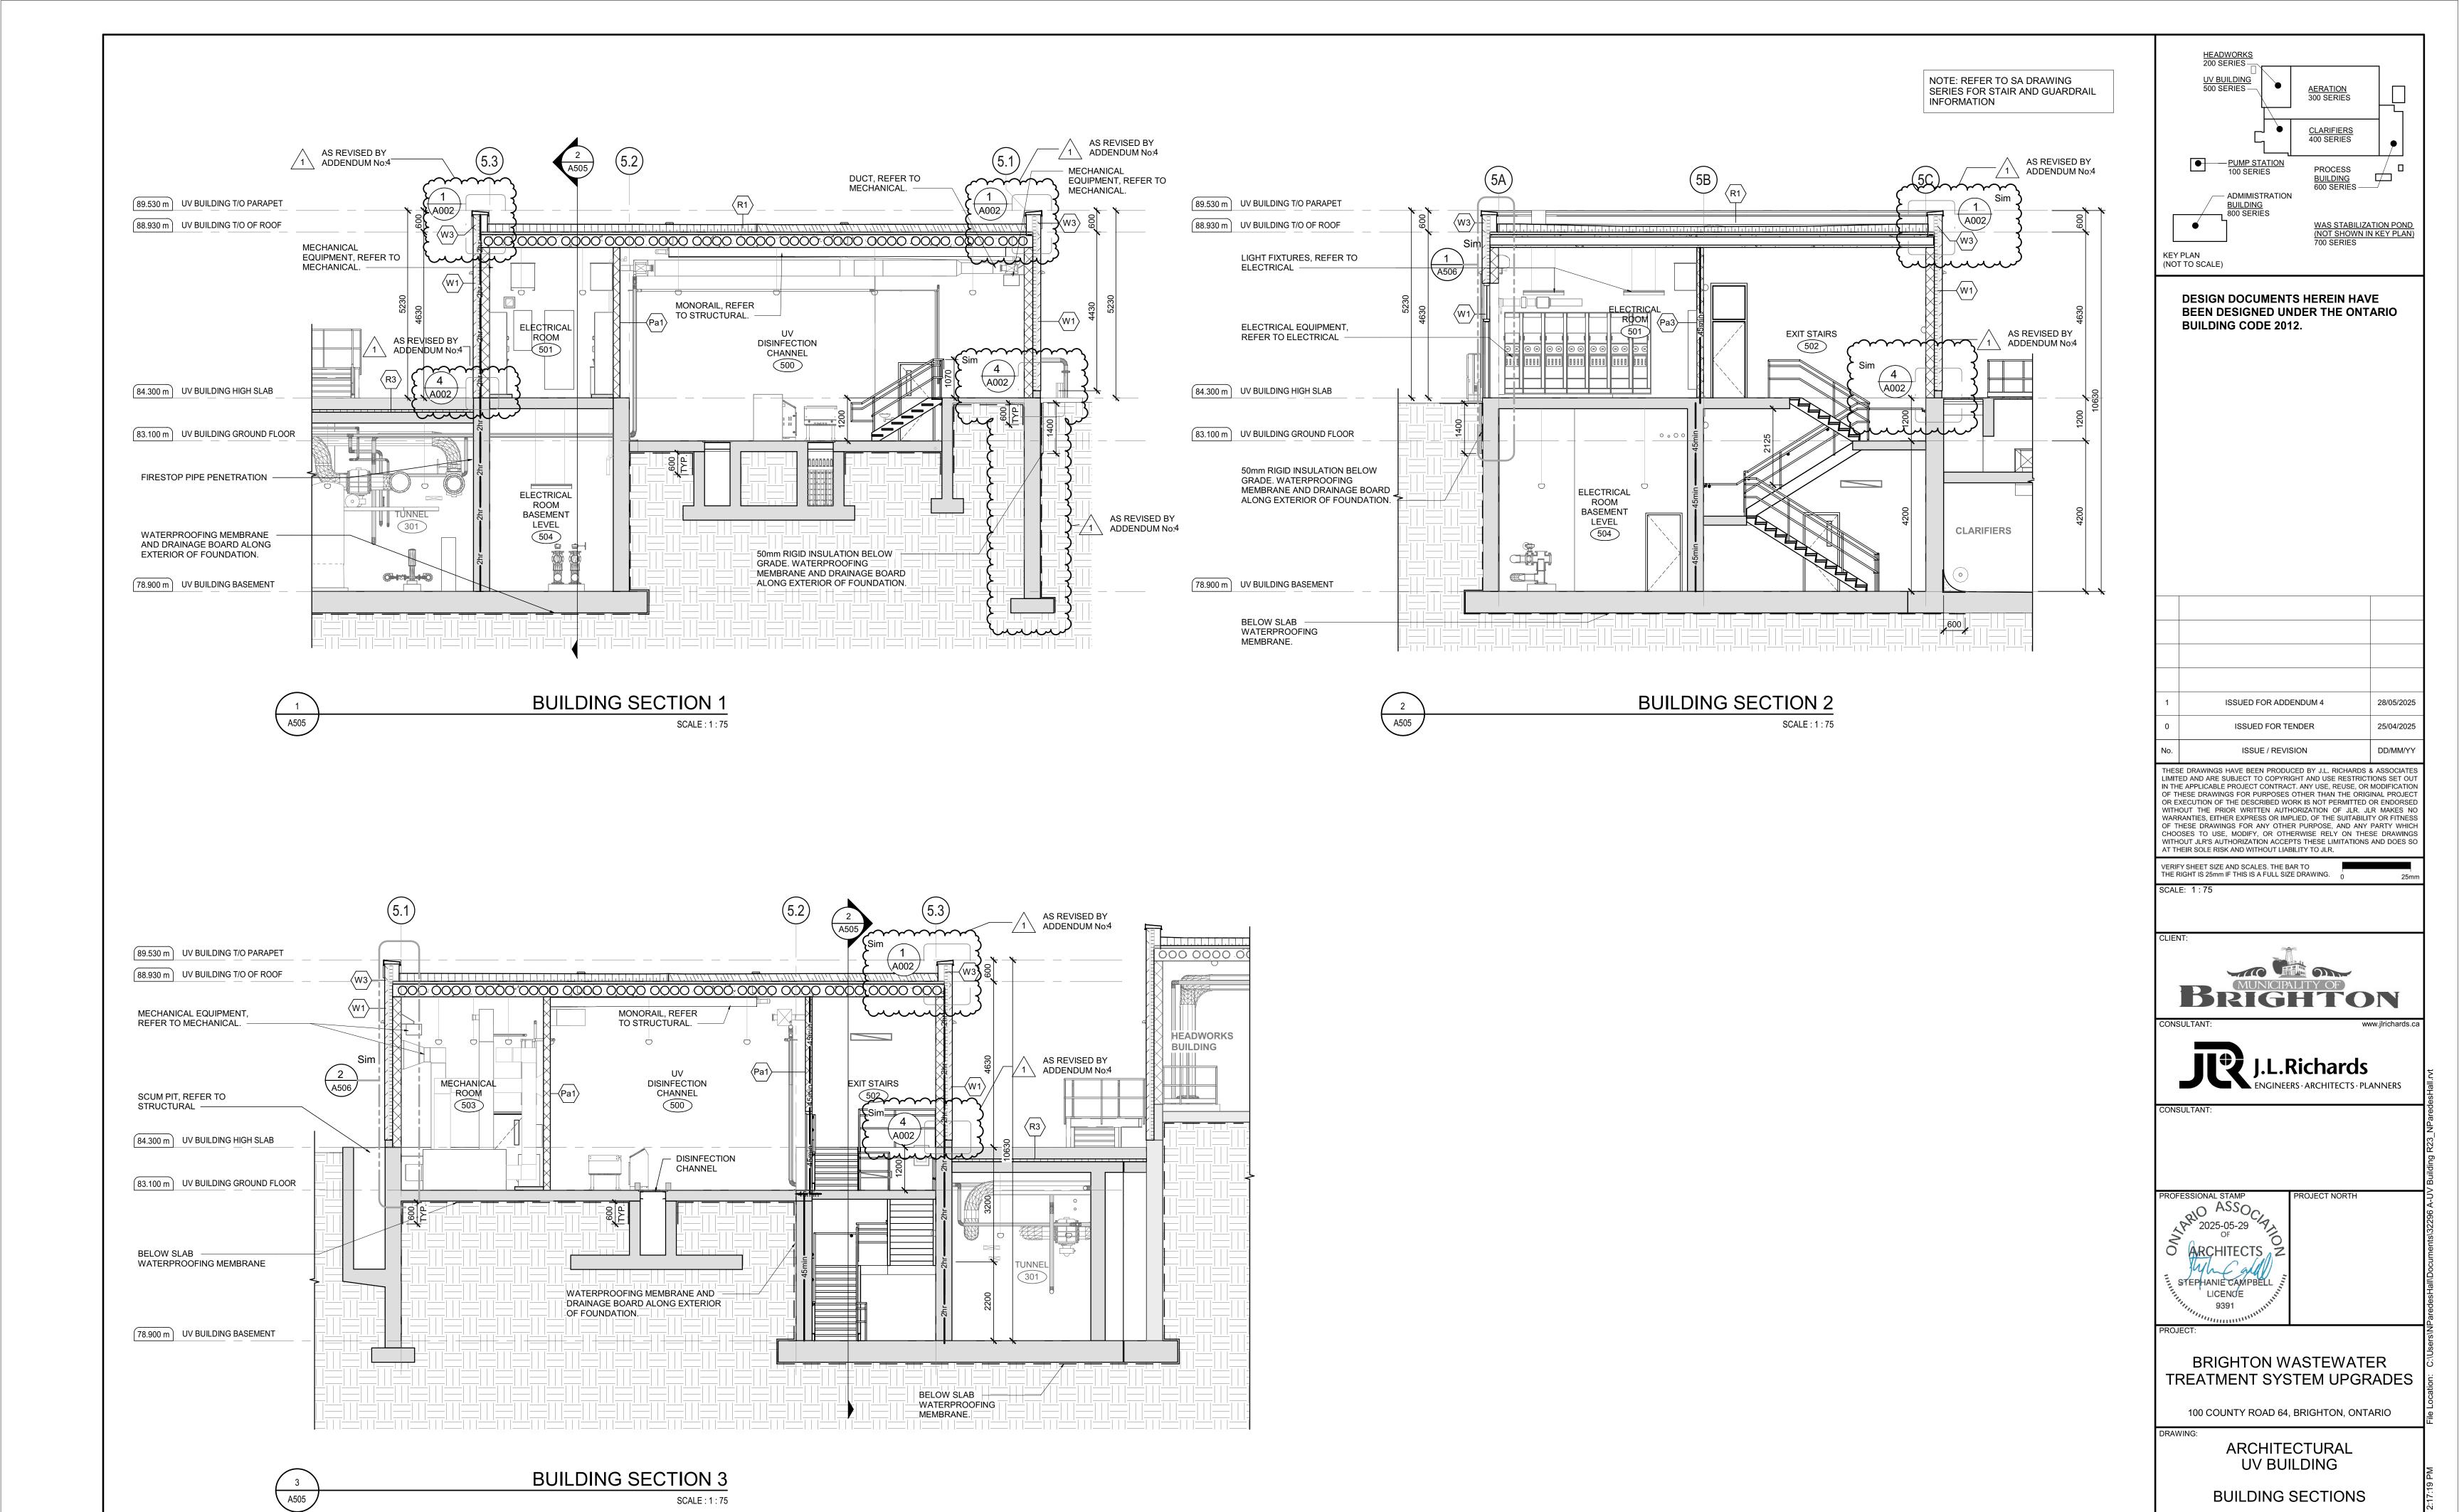

DESIGN: SC/KA


CHECKED: HB/SC


JLR #: 32296-001


RAWING #:


A505


SCALE: 1:75

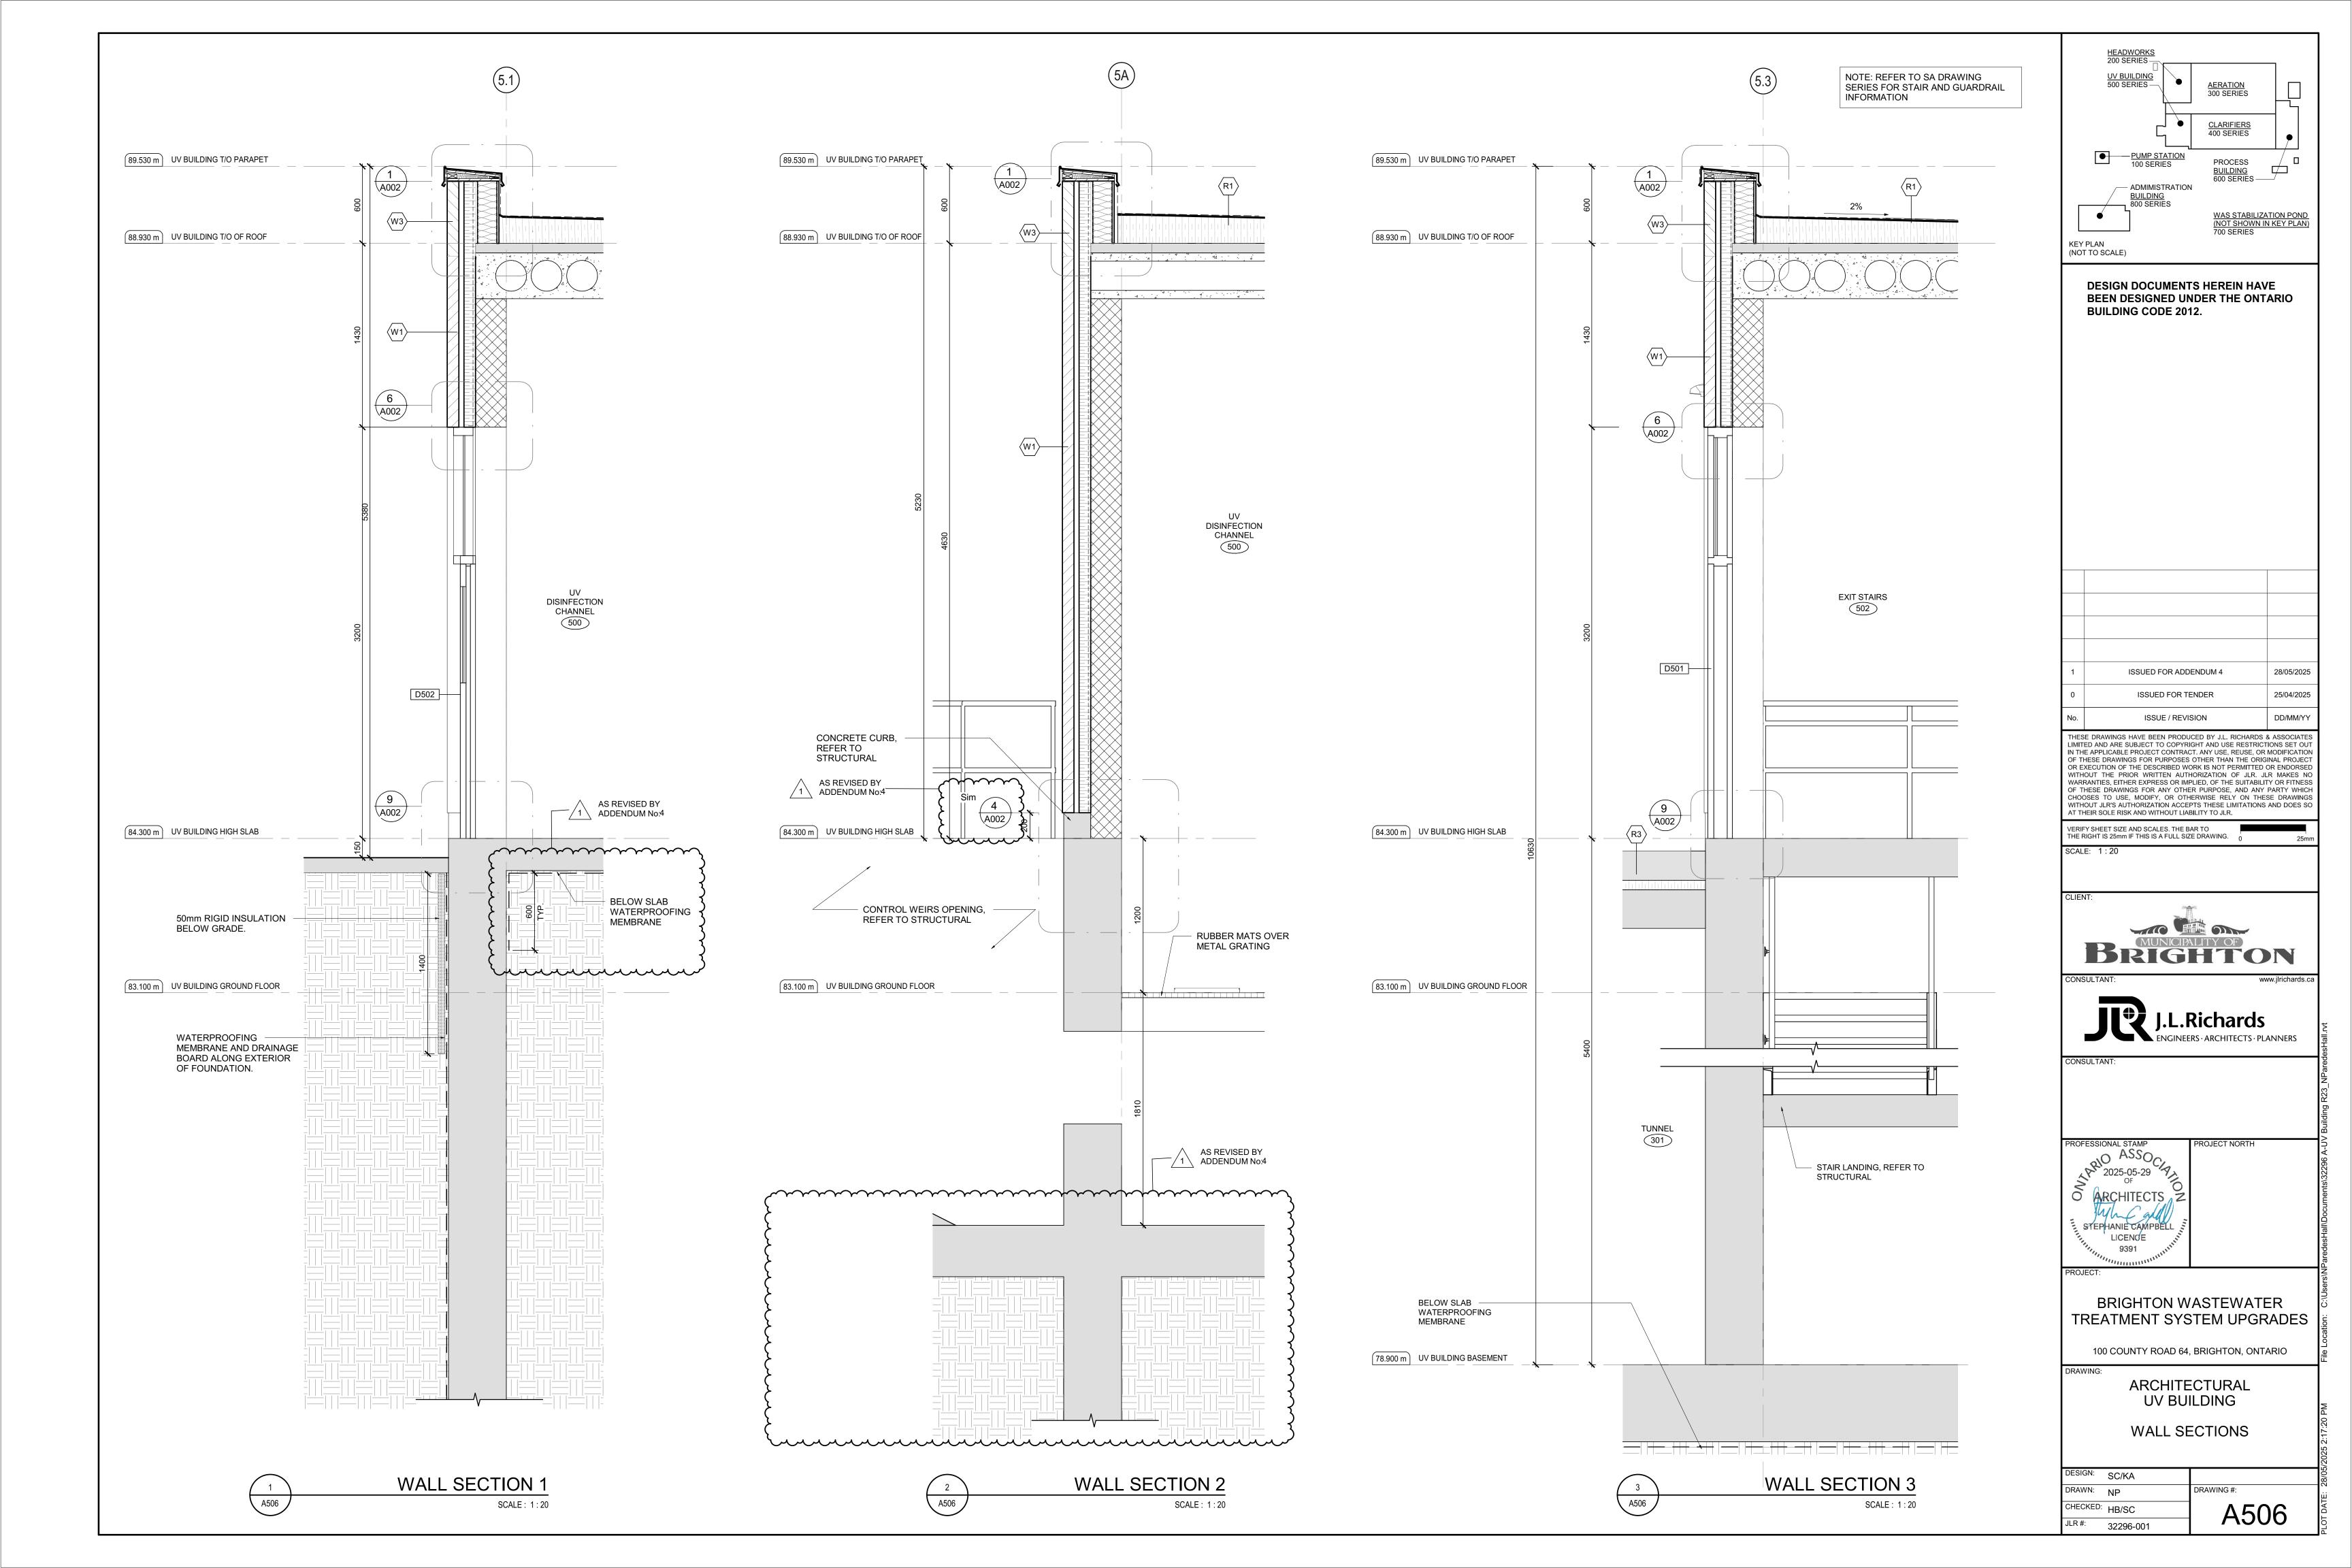


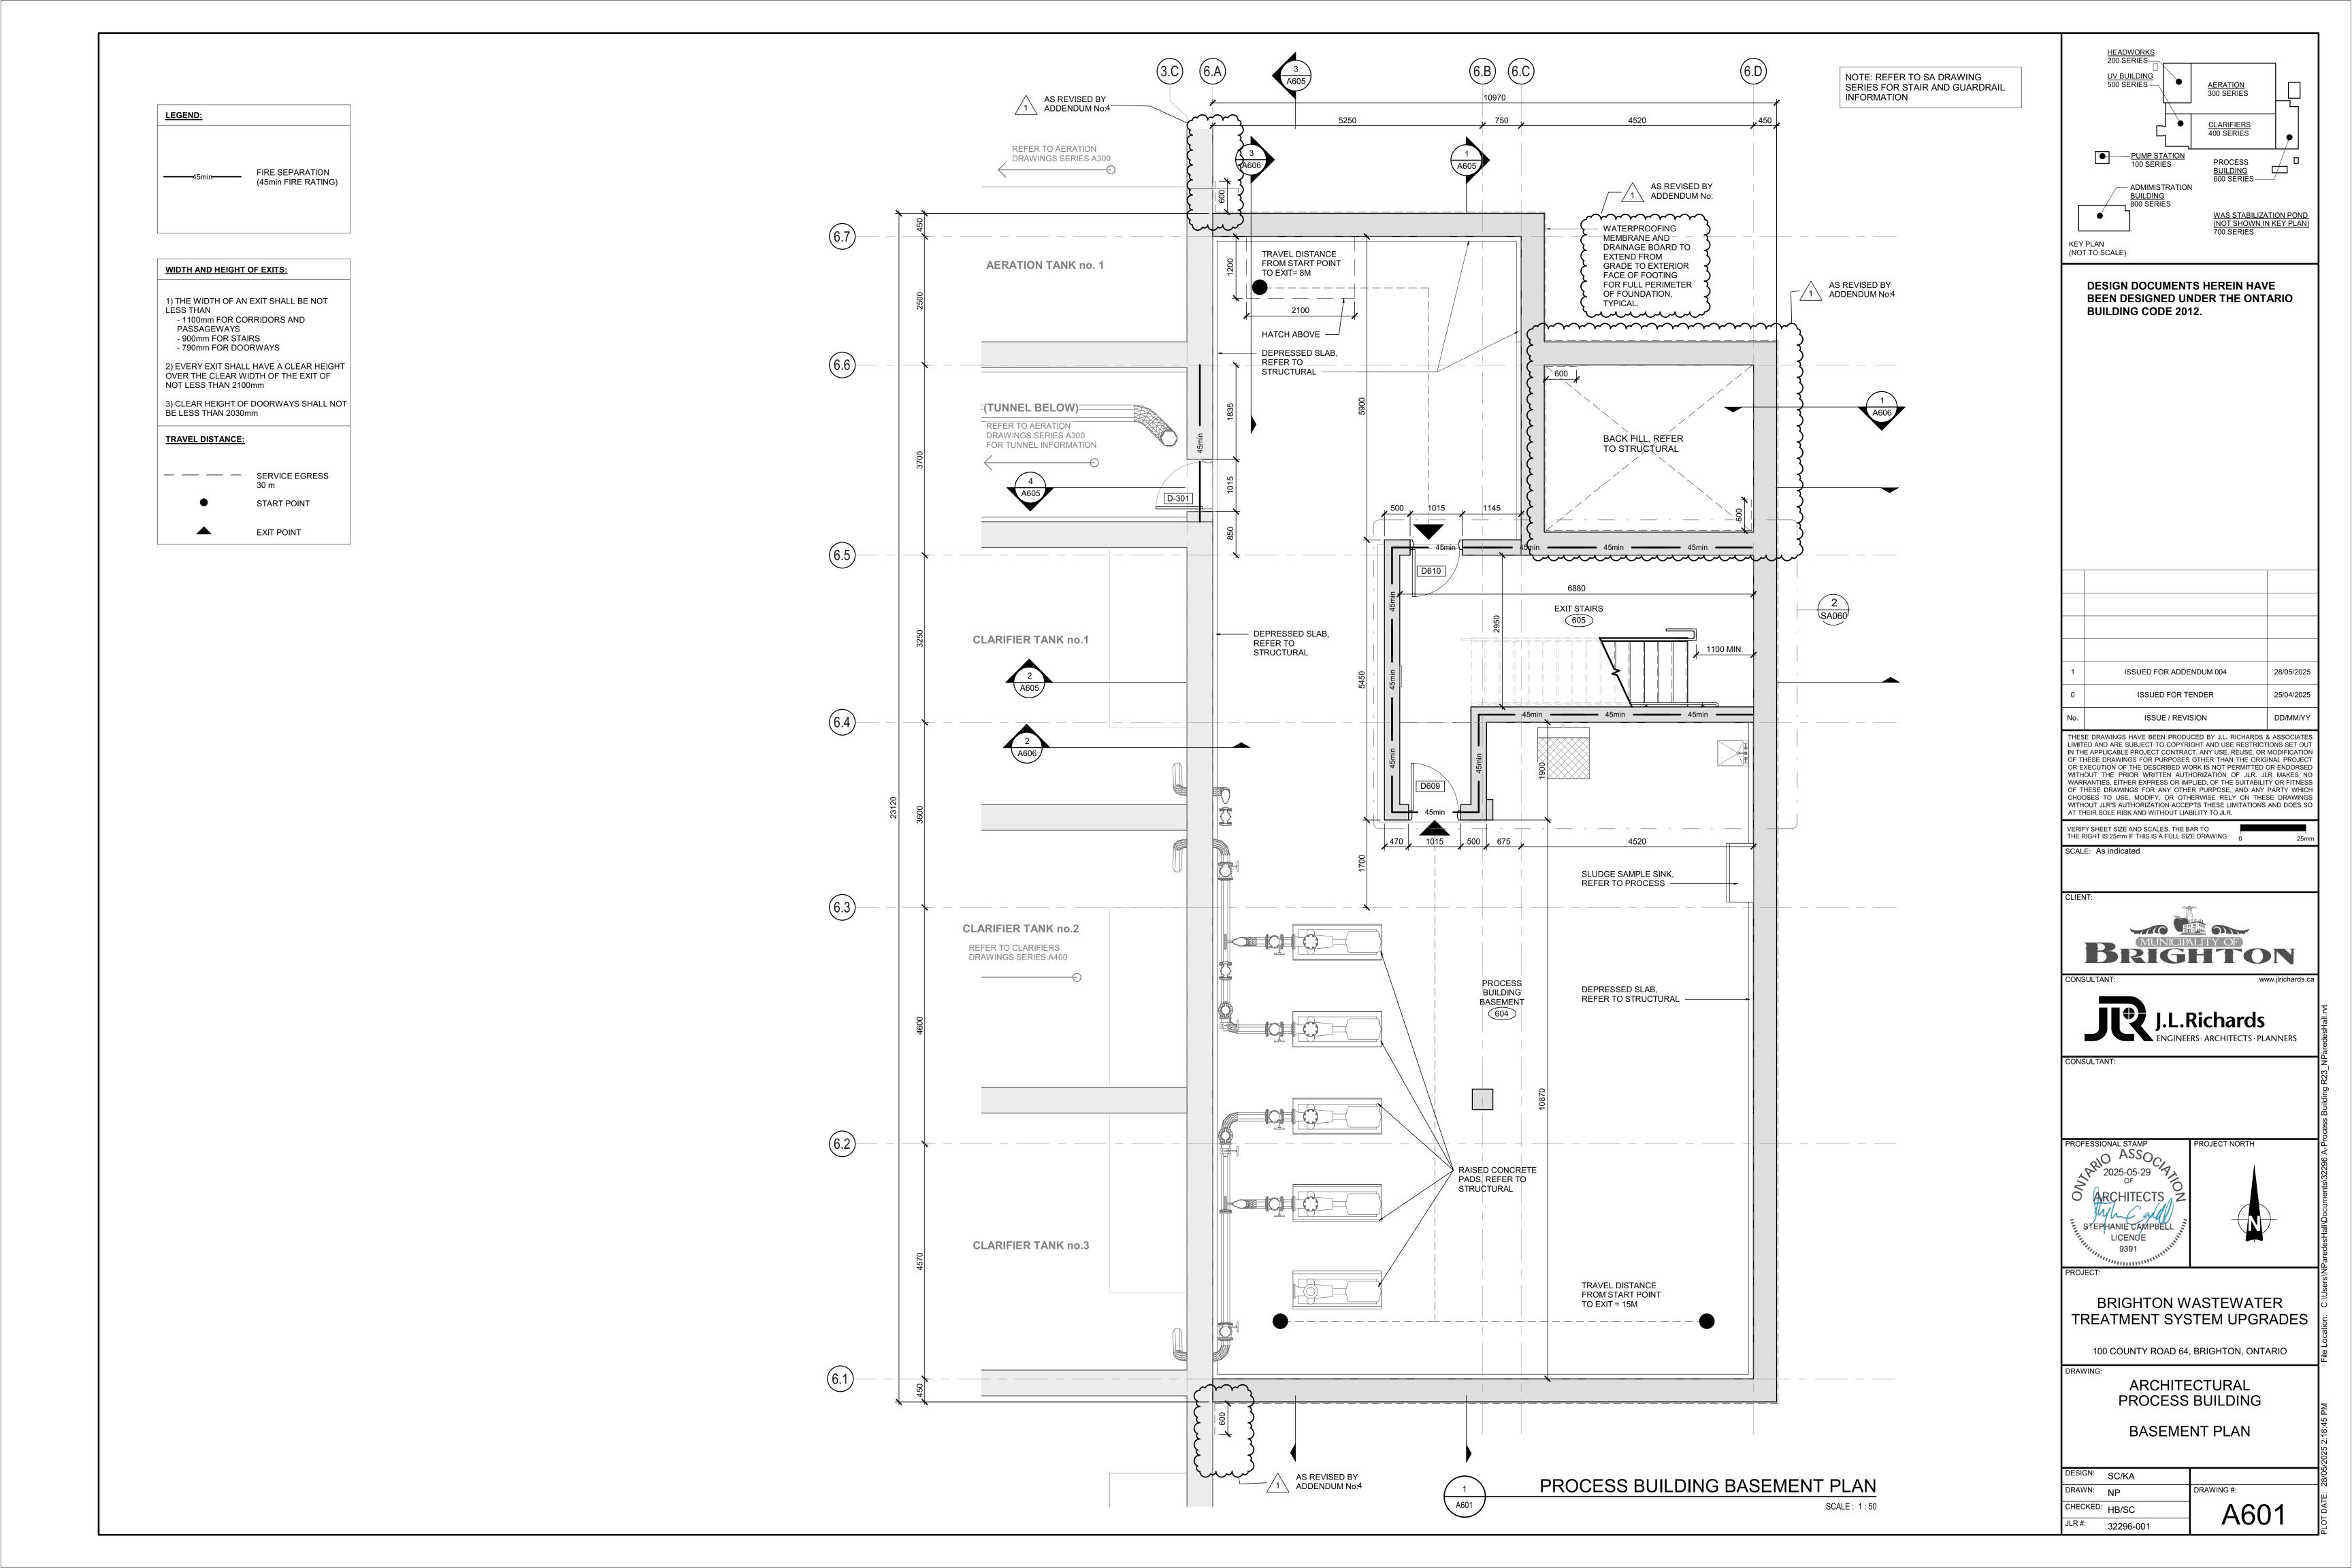


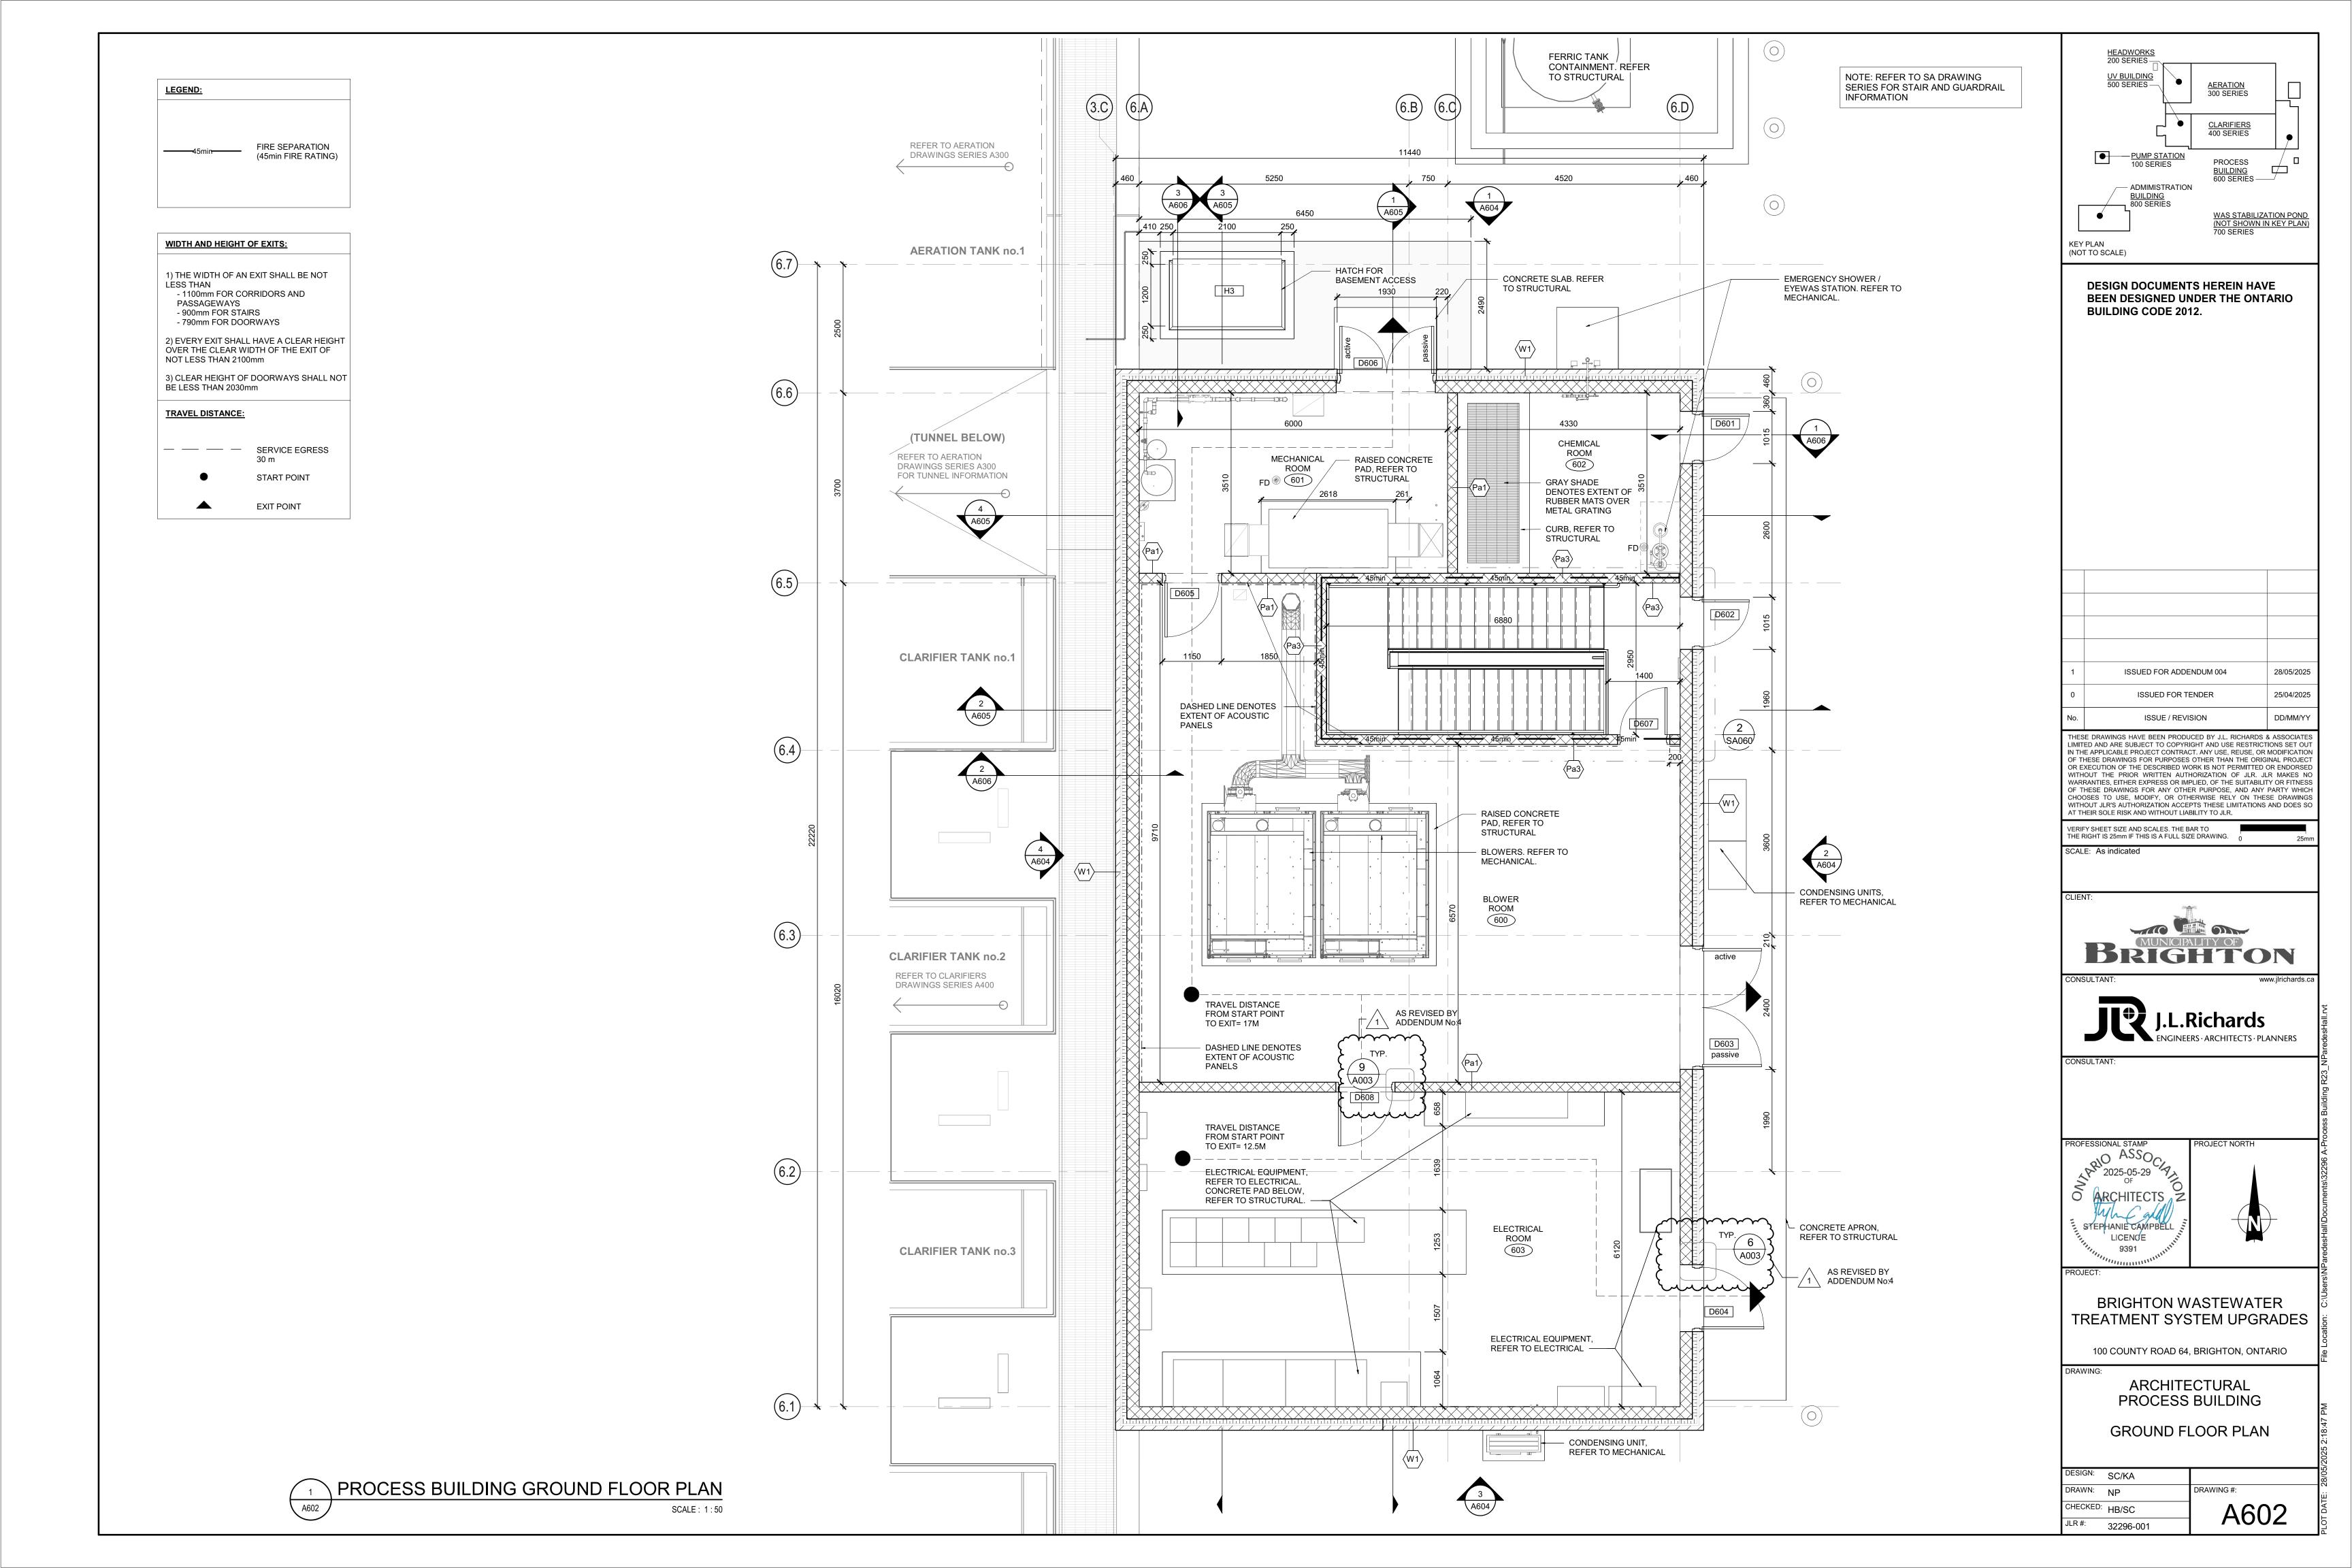


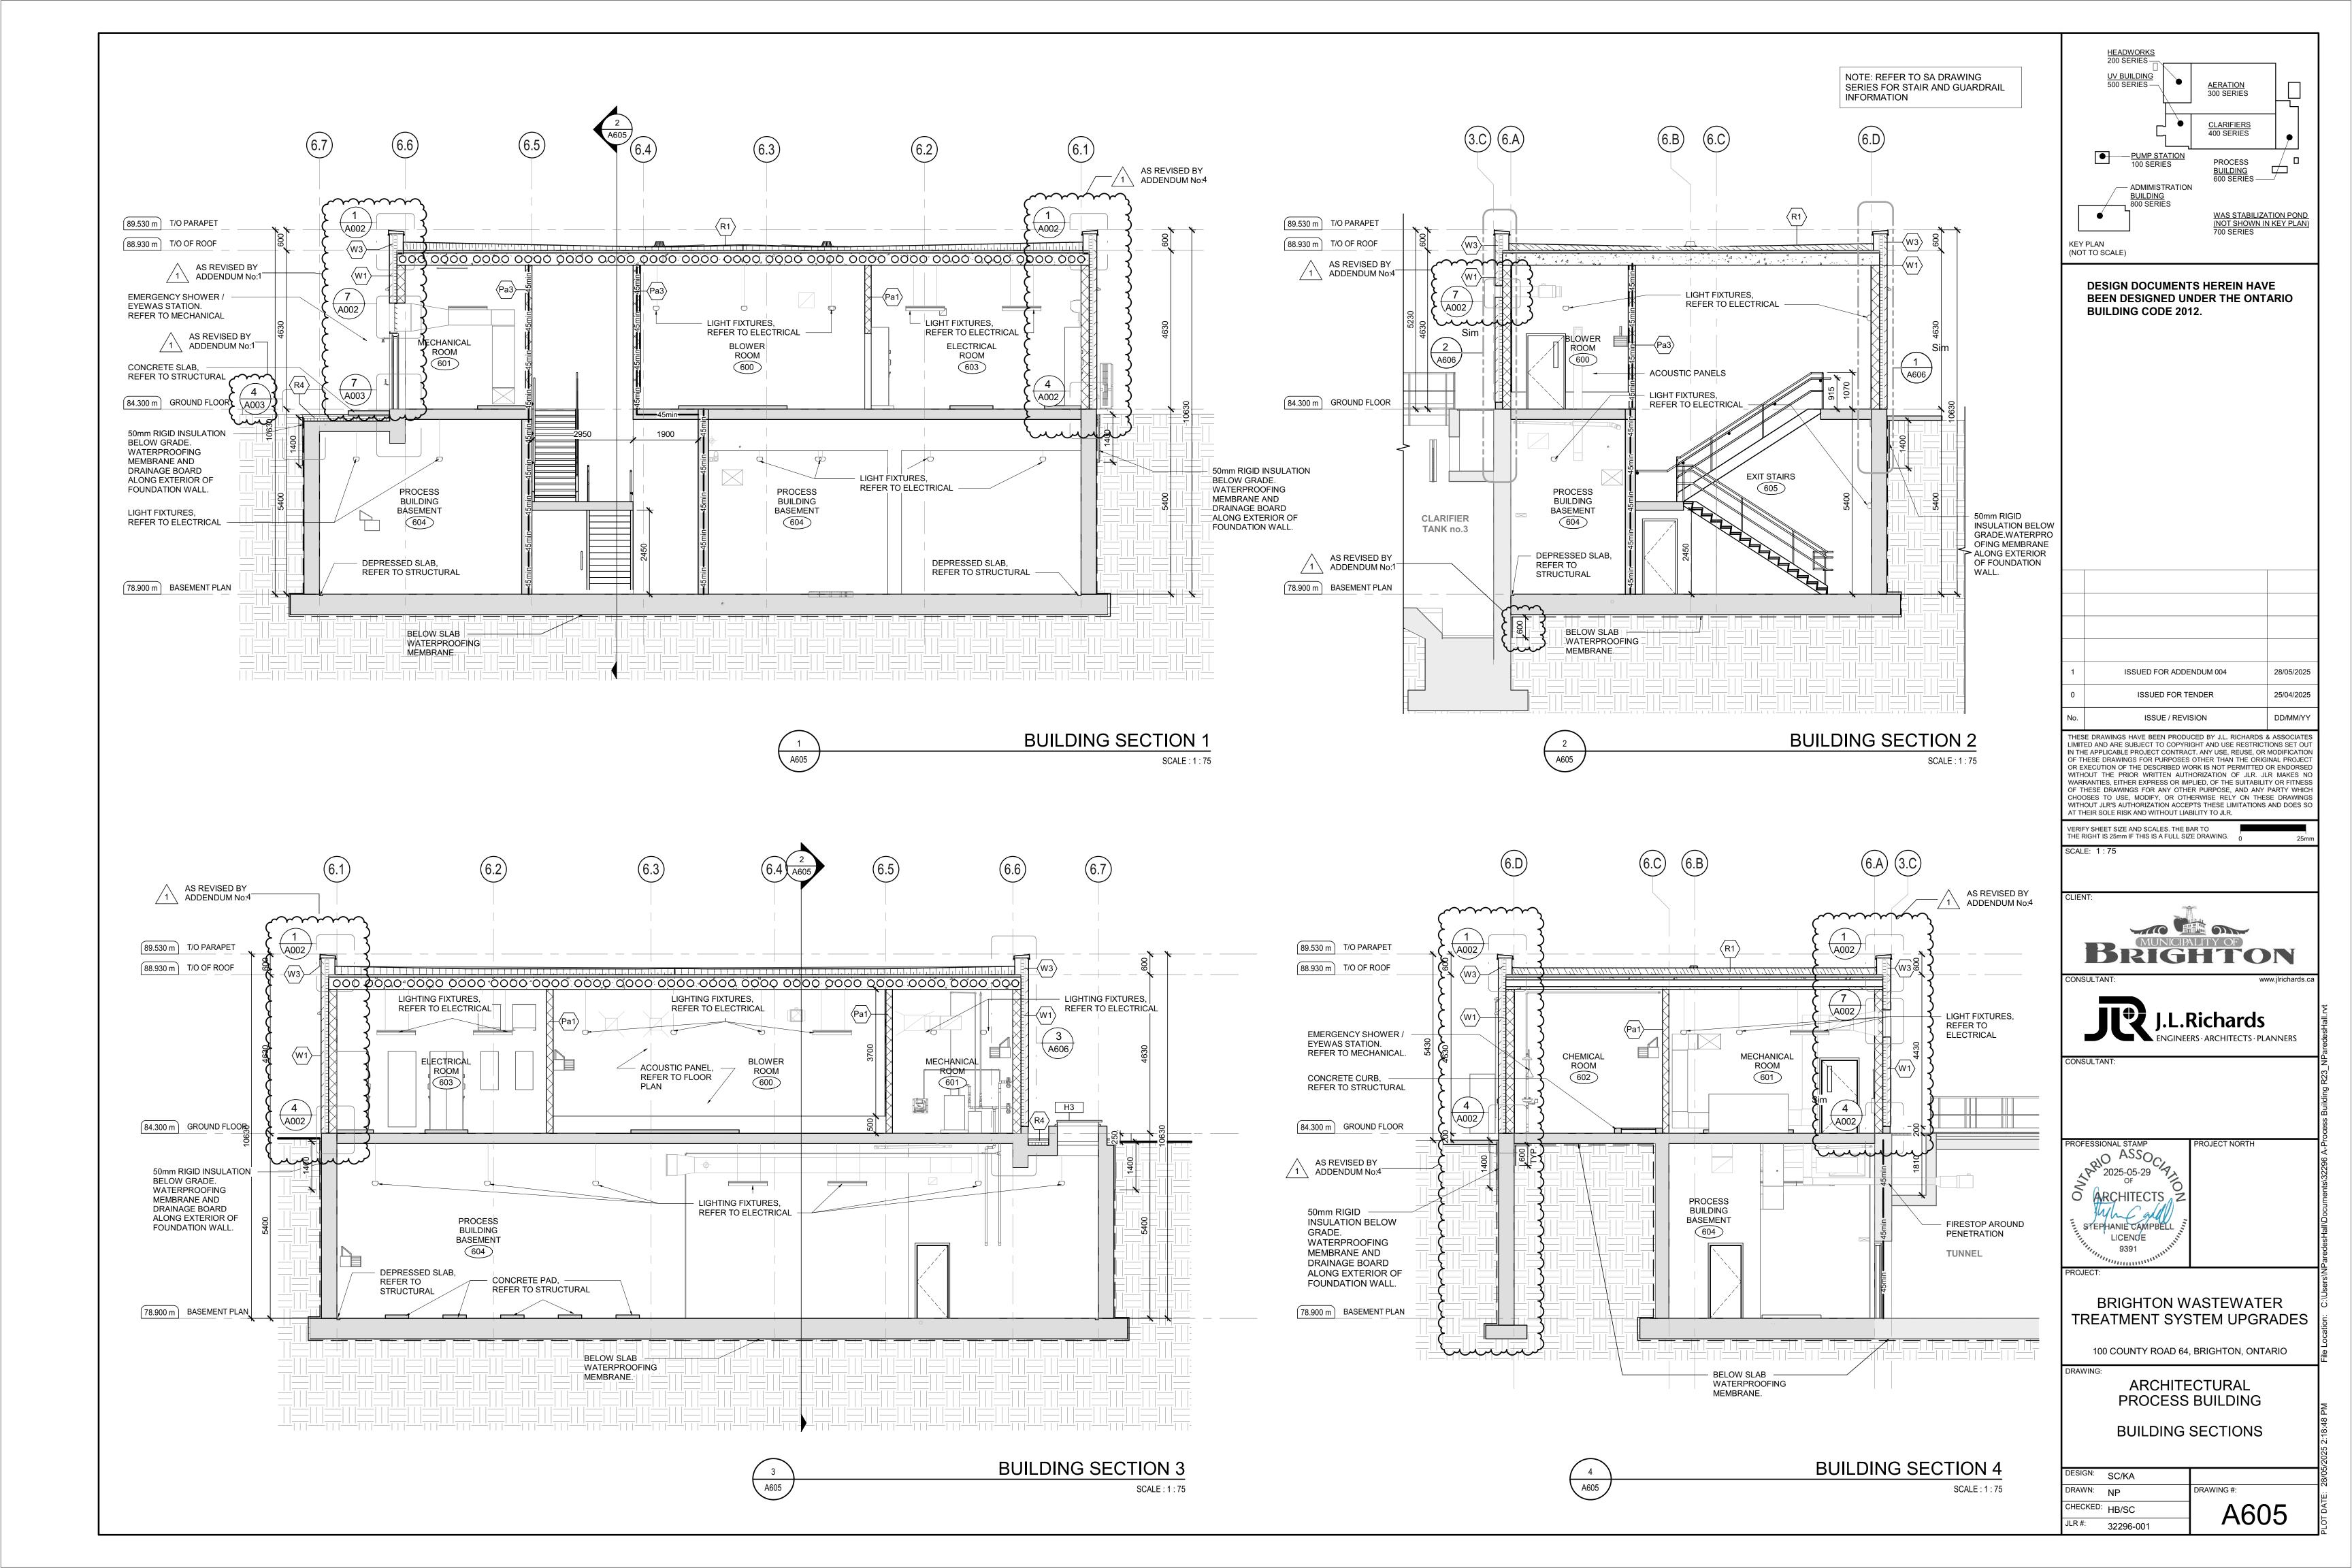

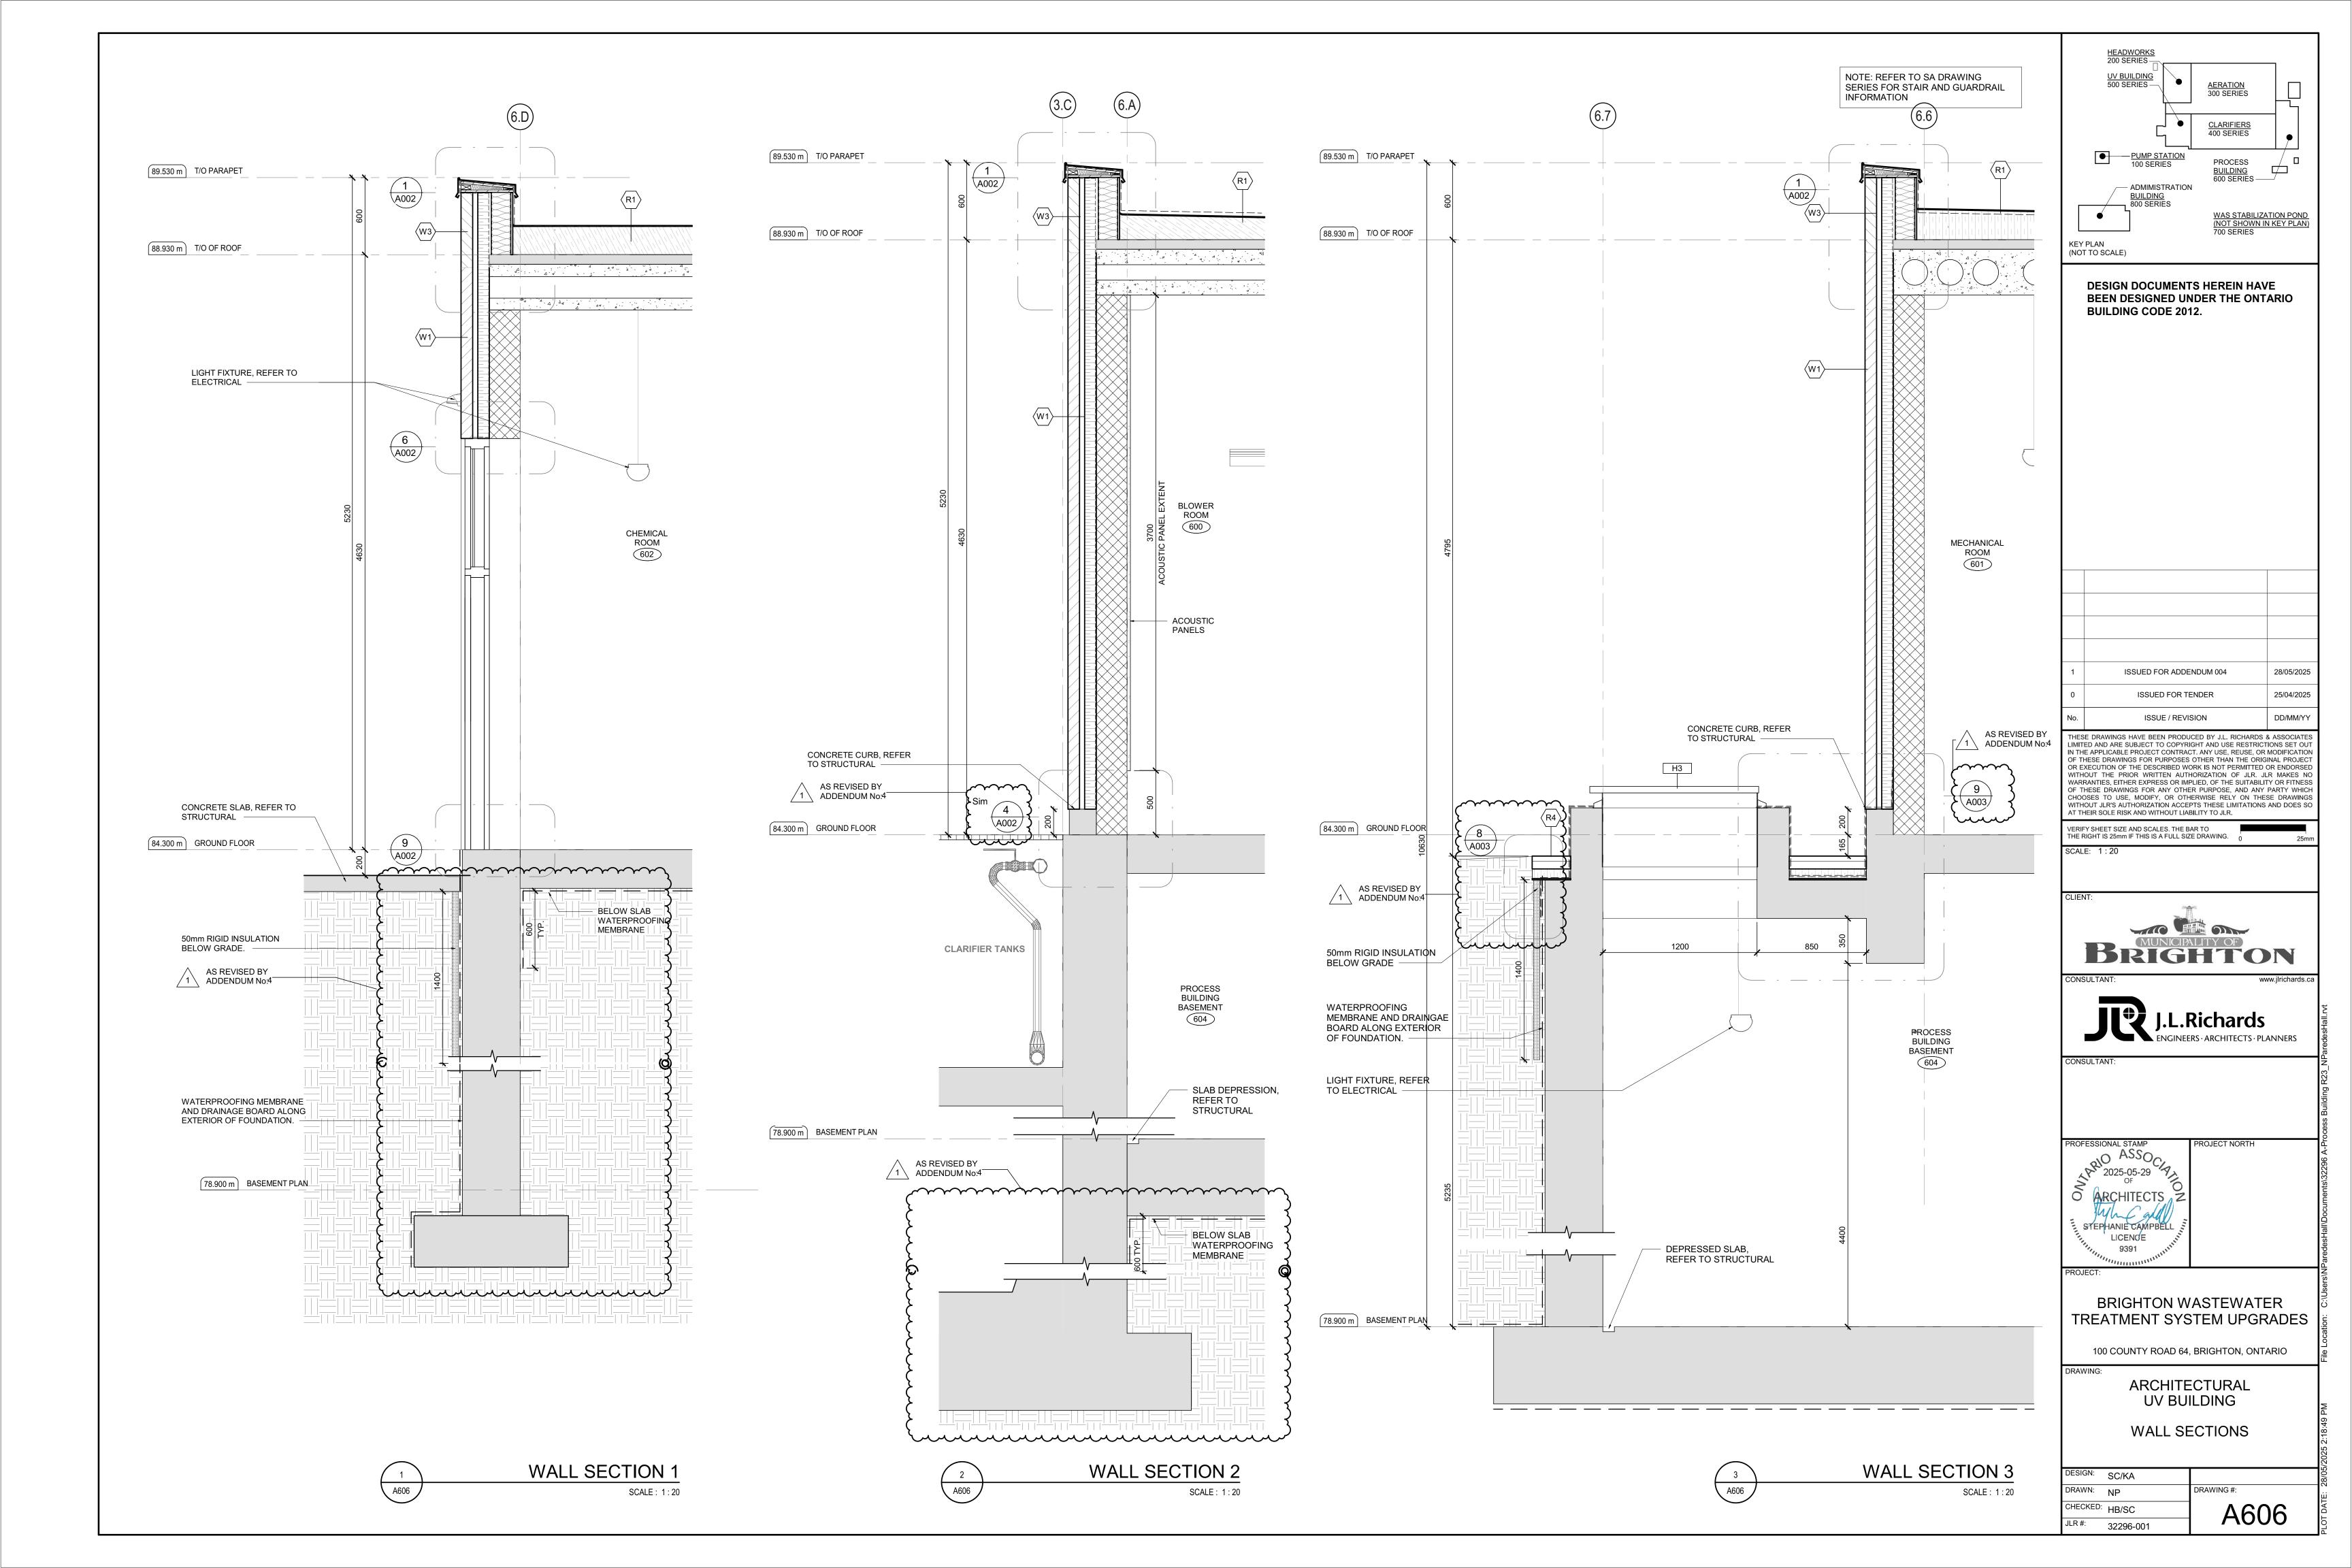


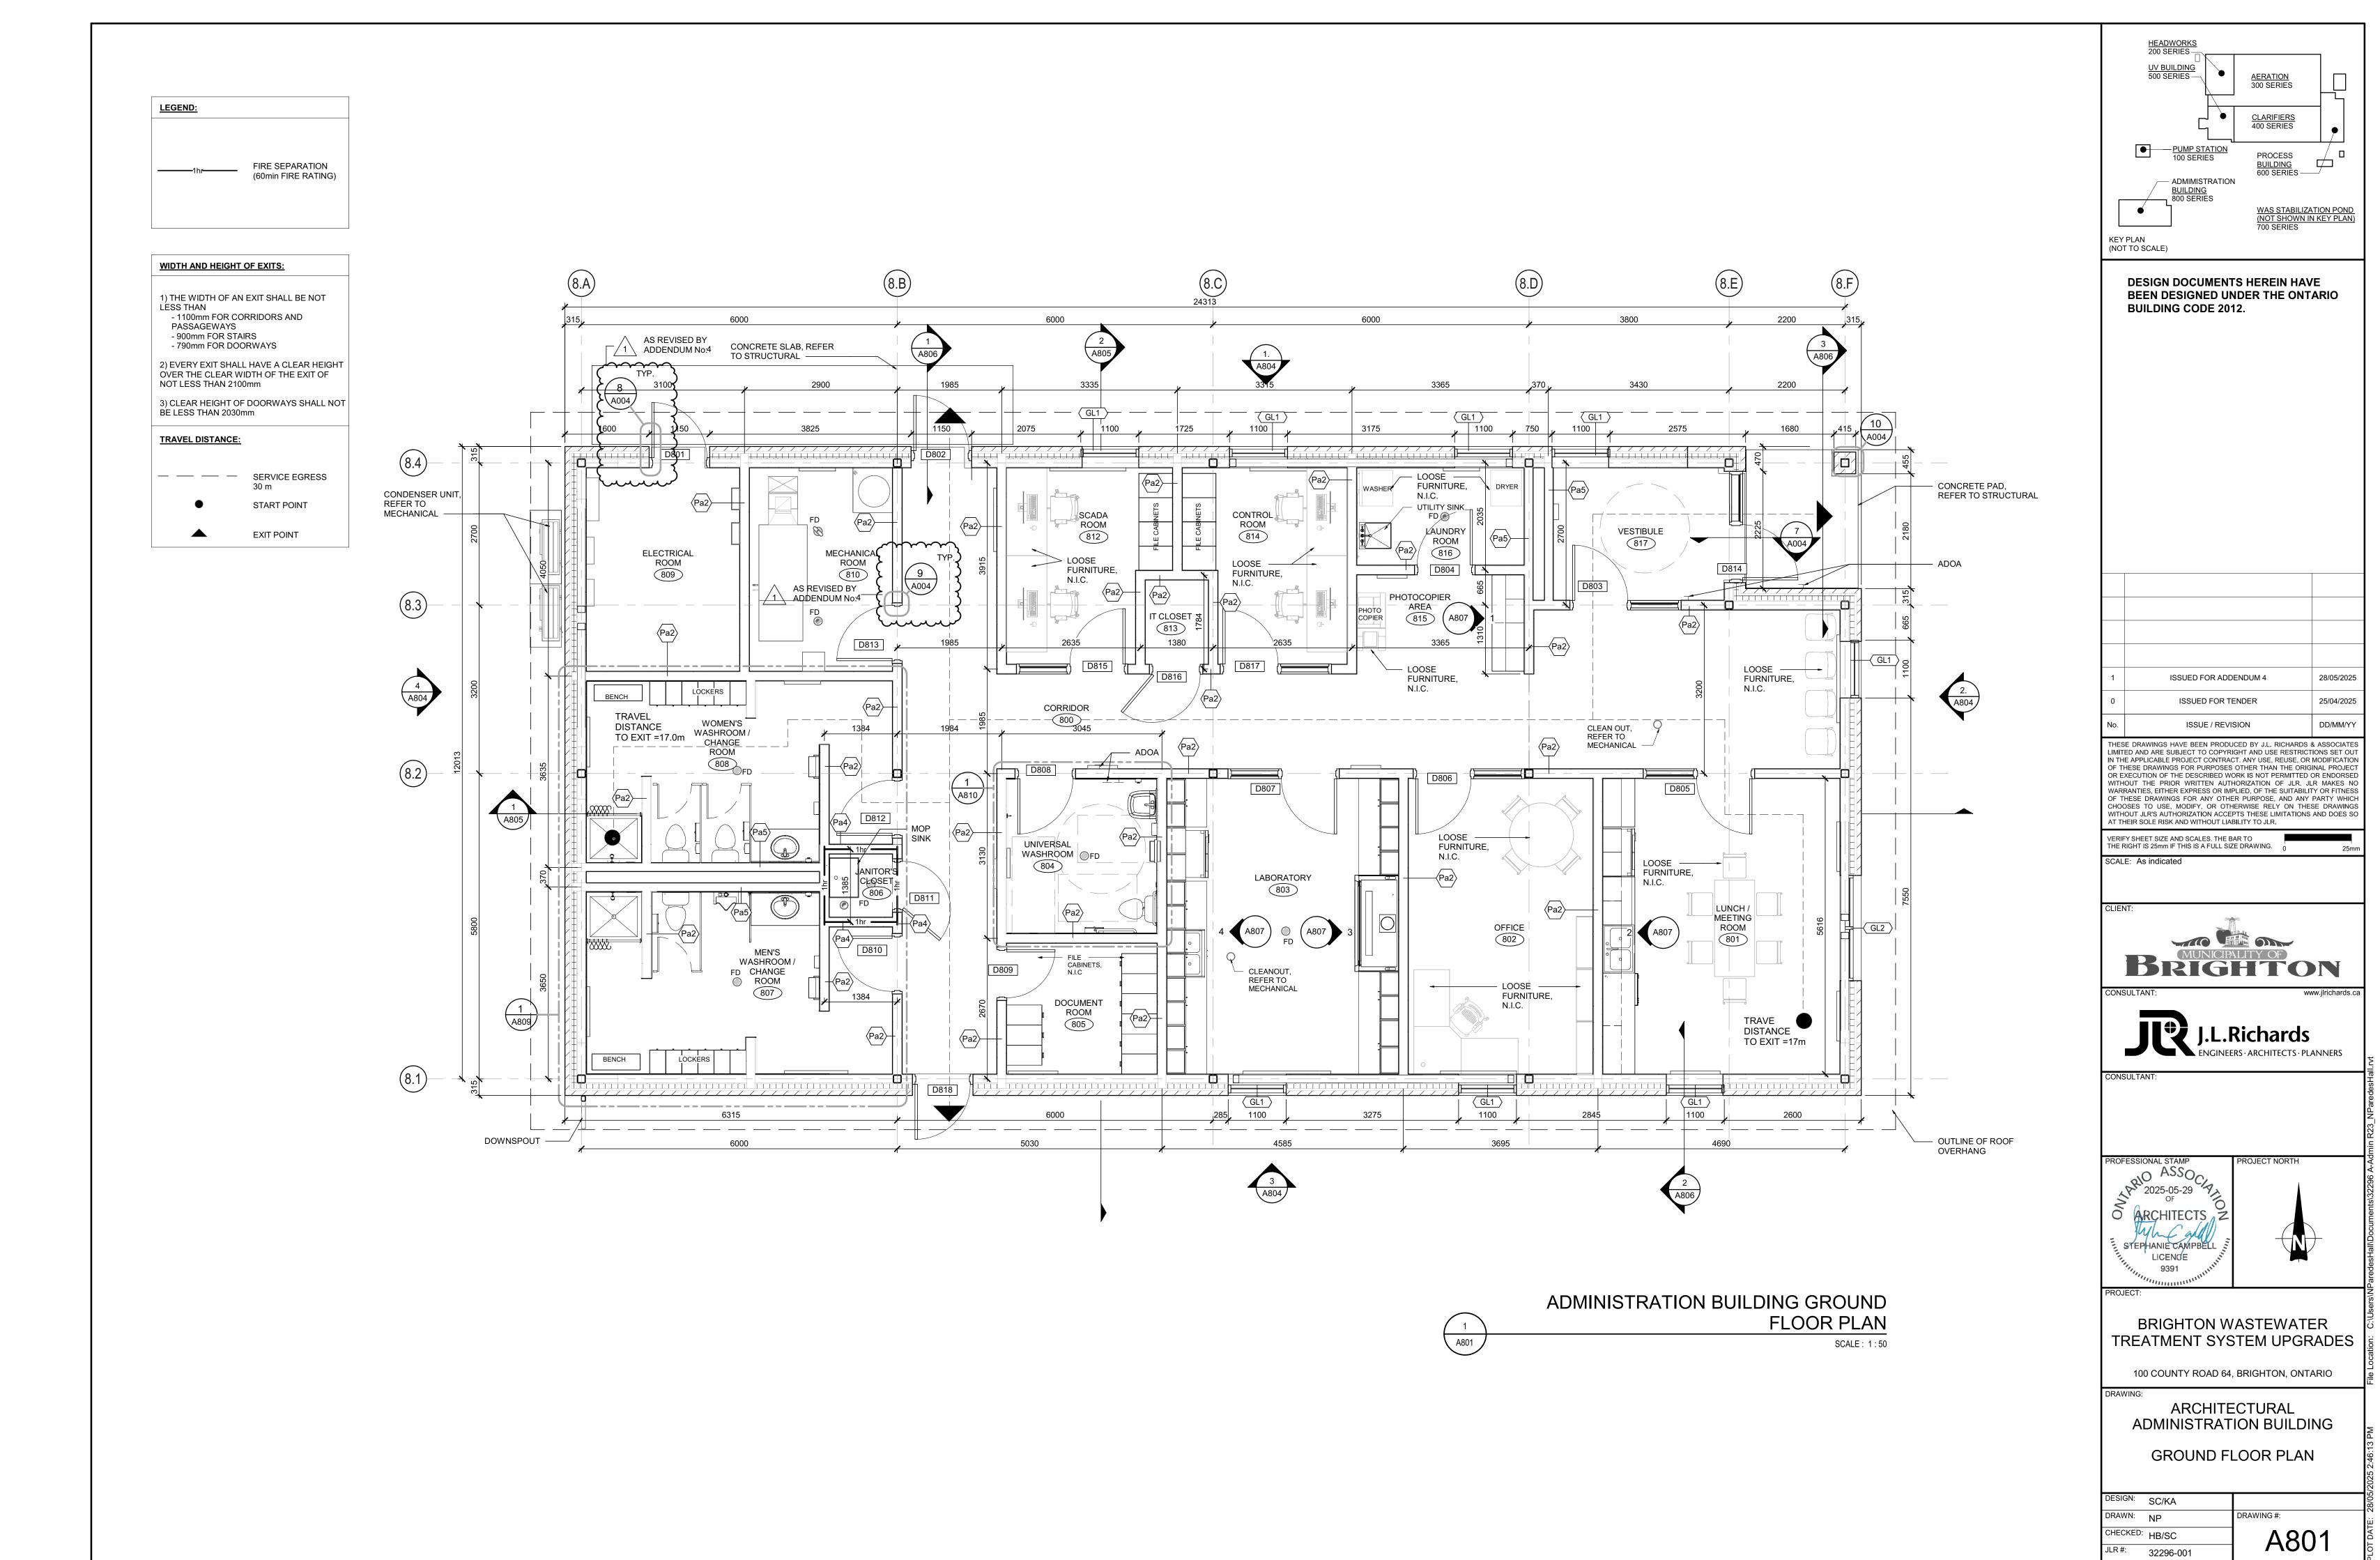

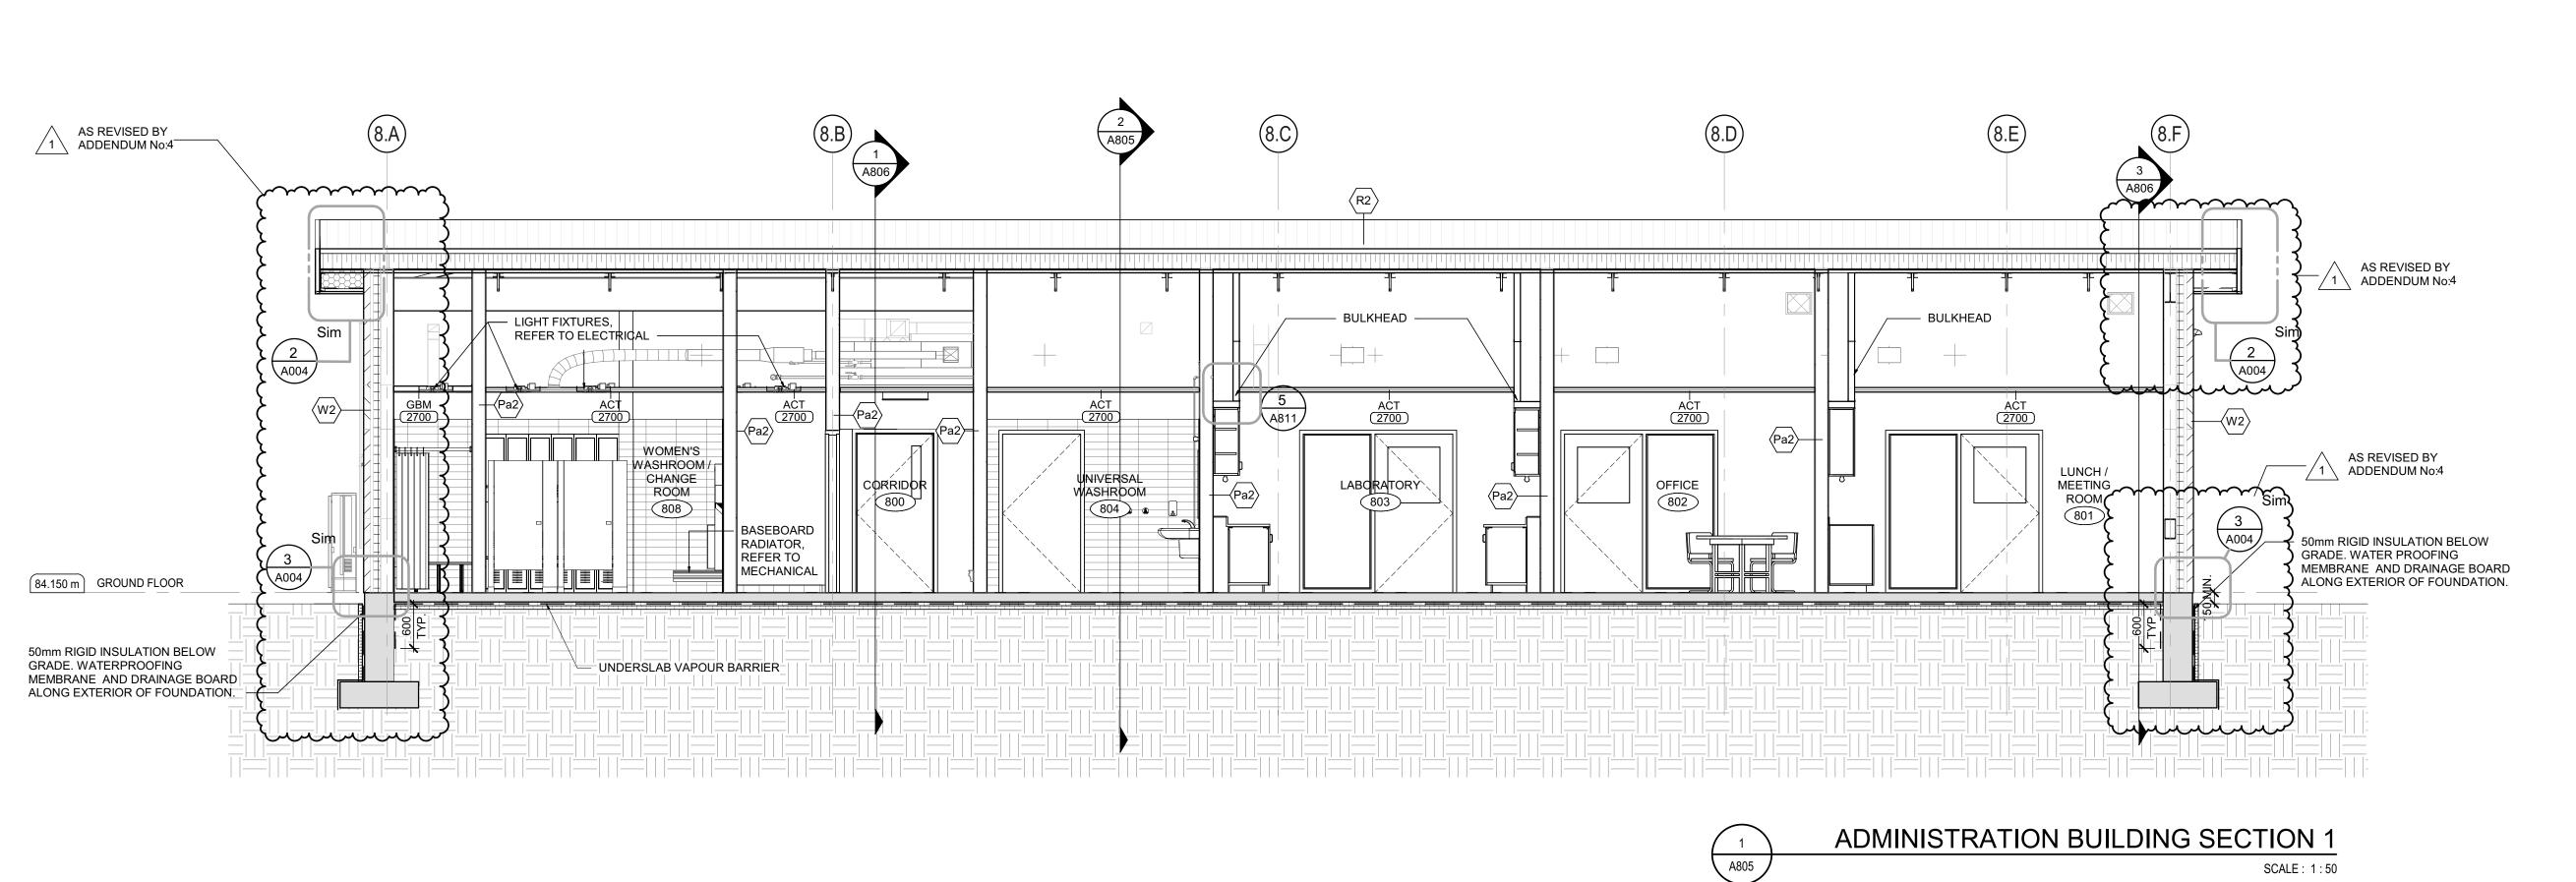

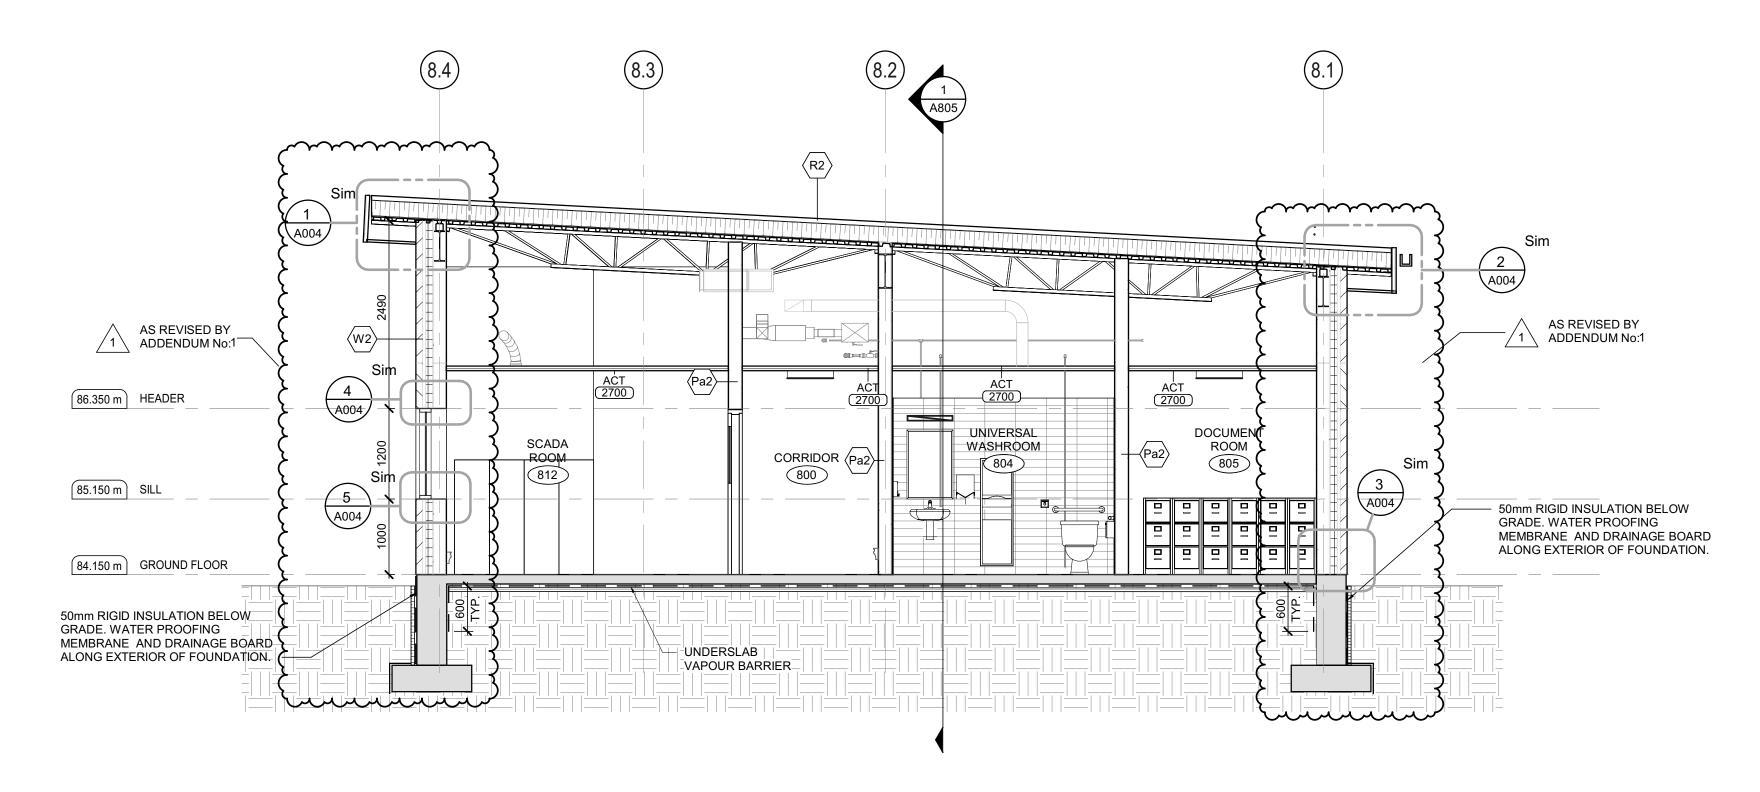



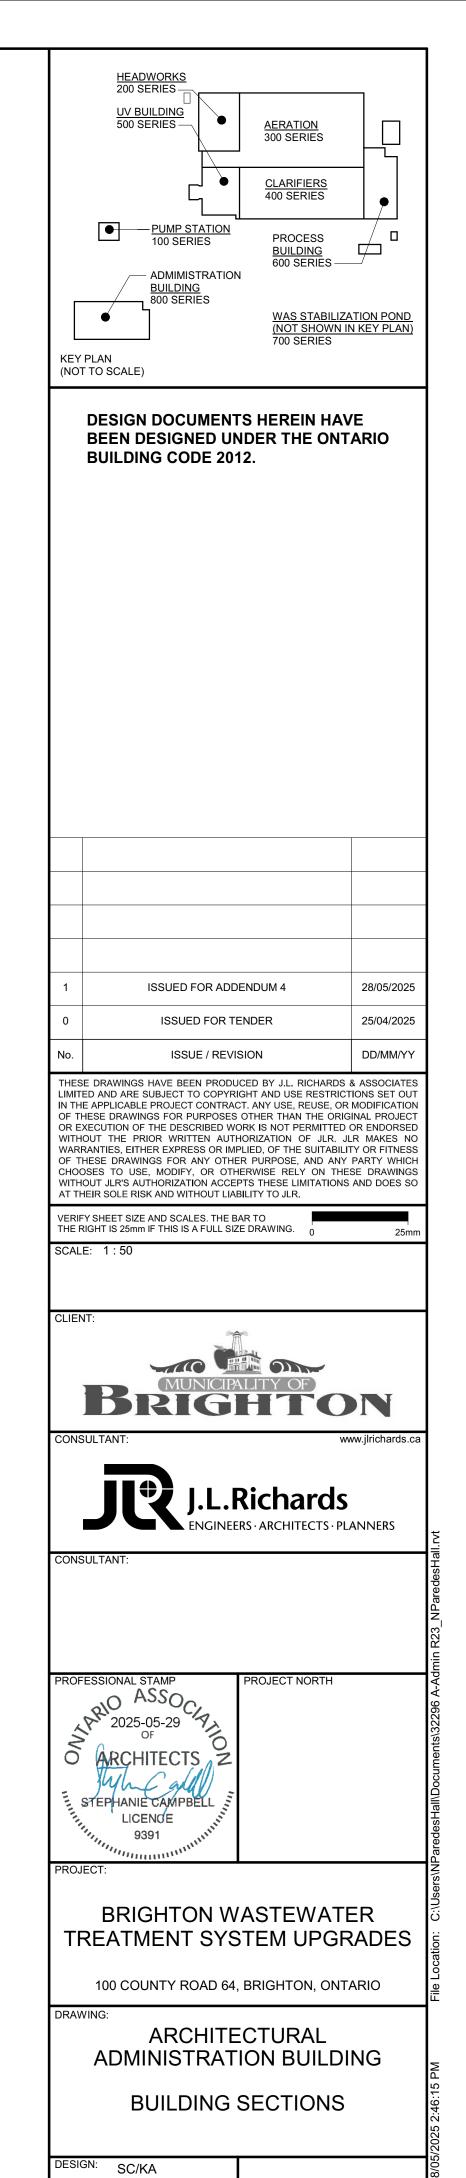


DRAWN: NP


CHECKED: HB/SC


JLR #: 32296-001


DRAWING #:

A805

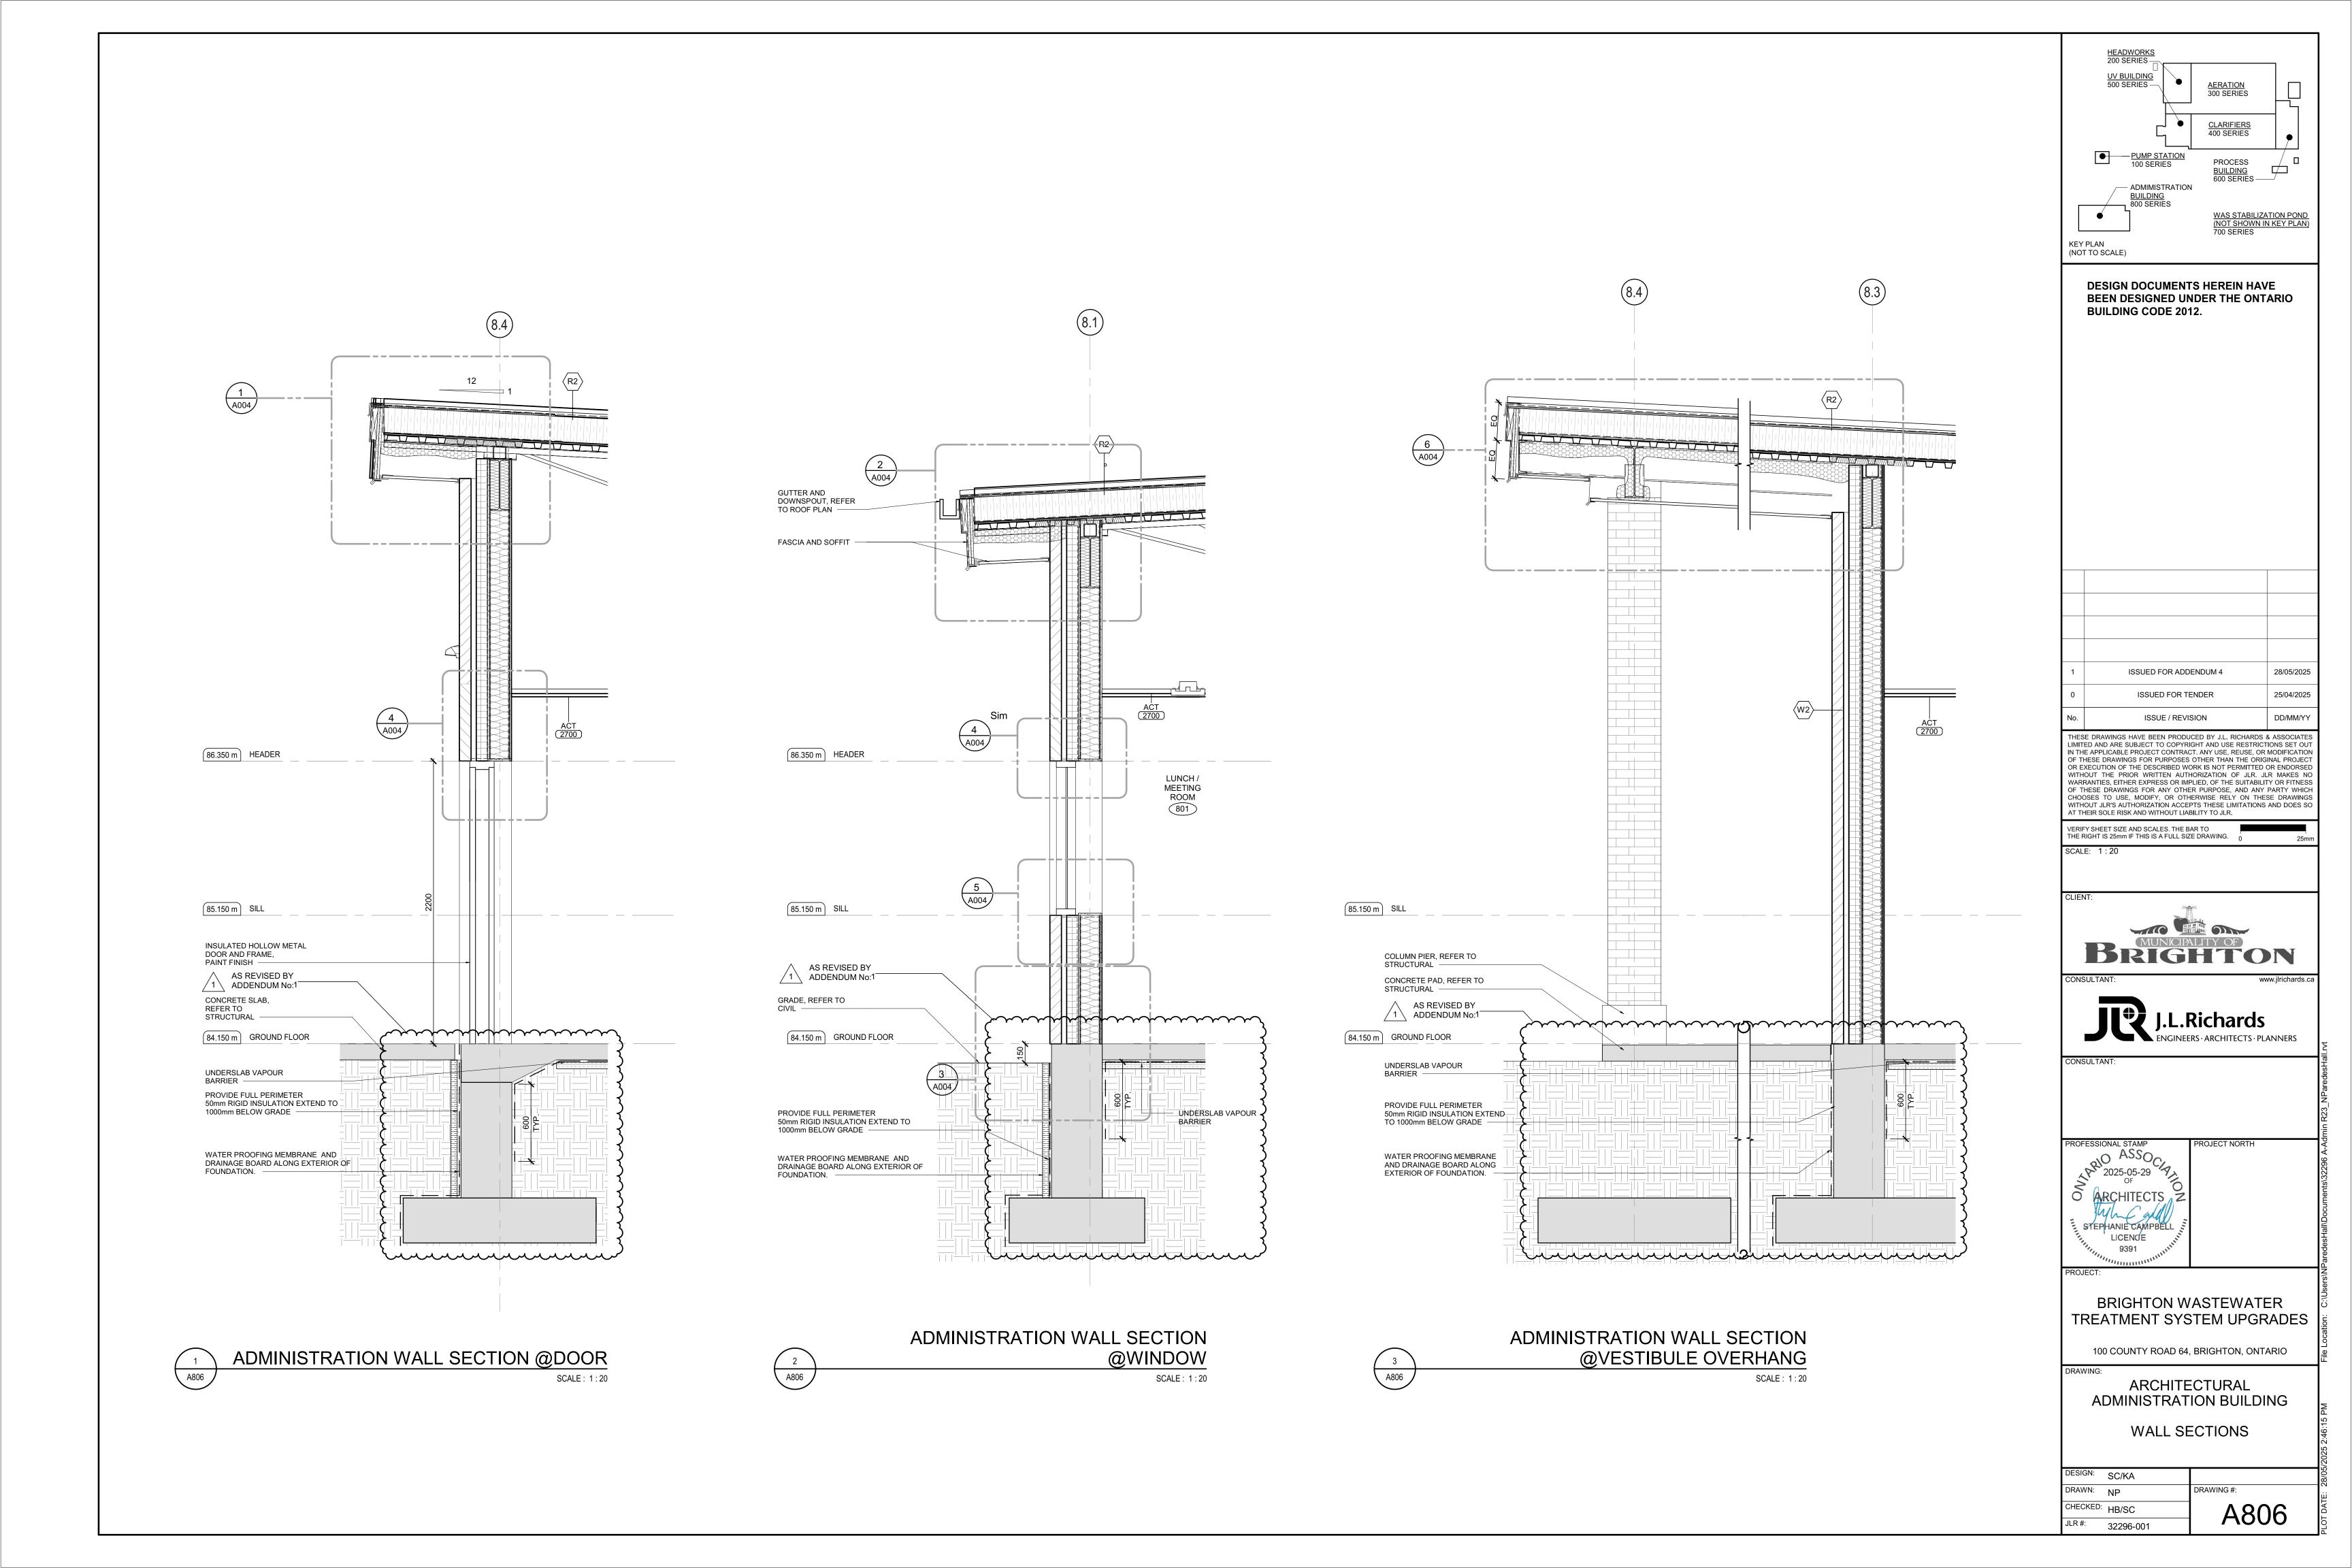

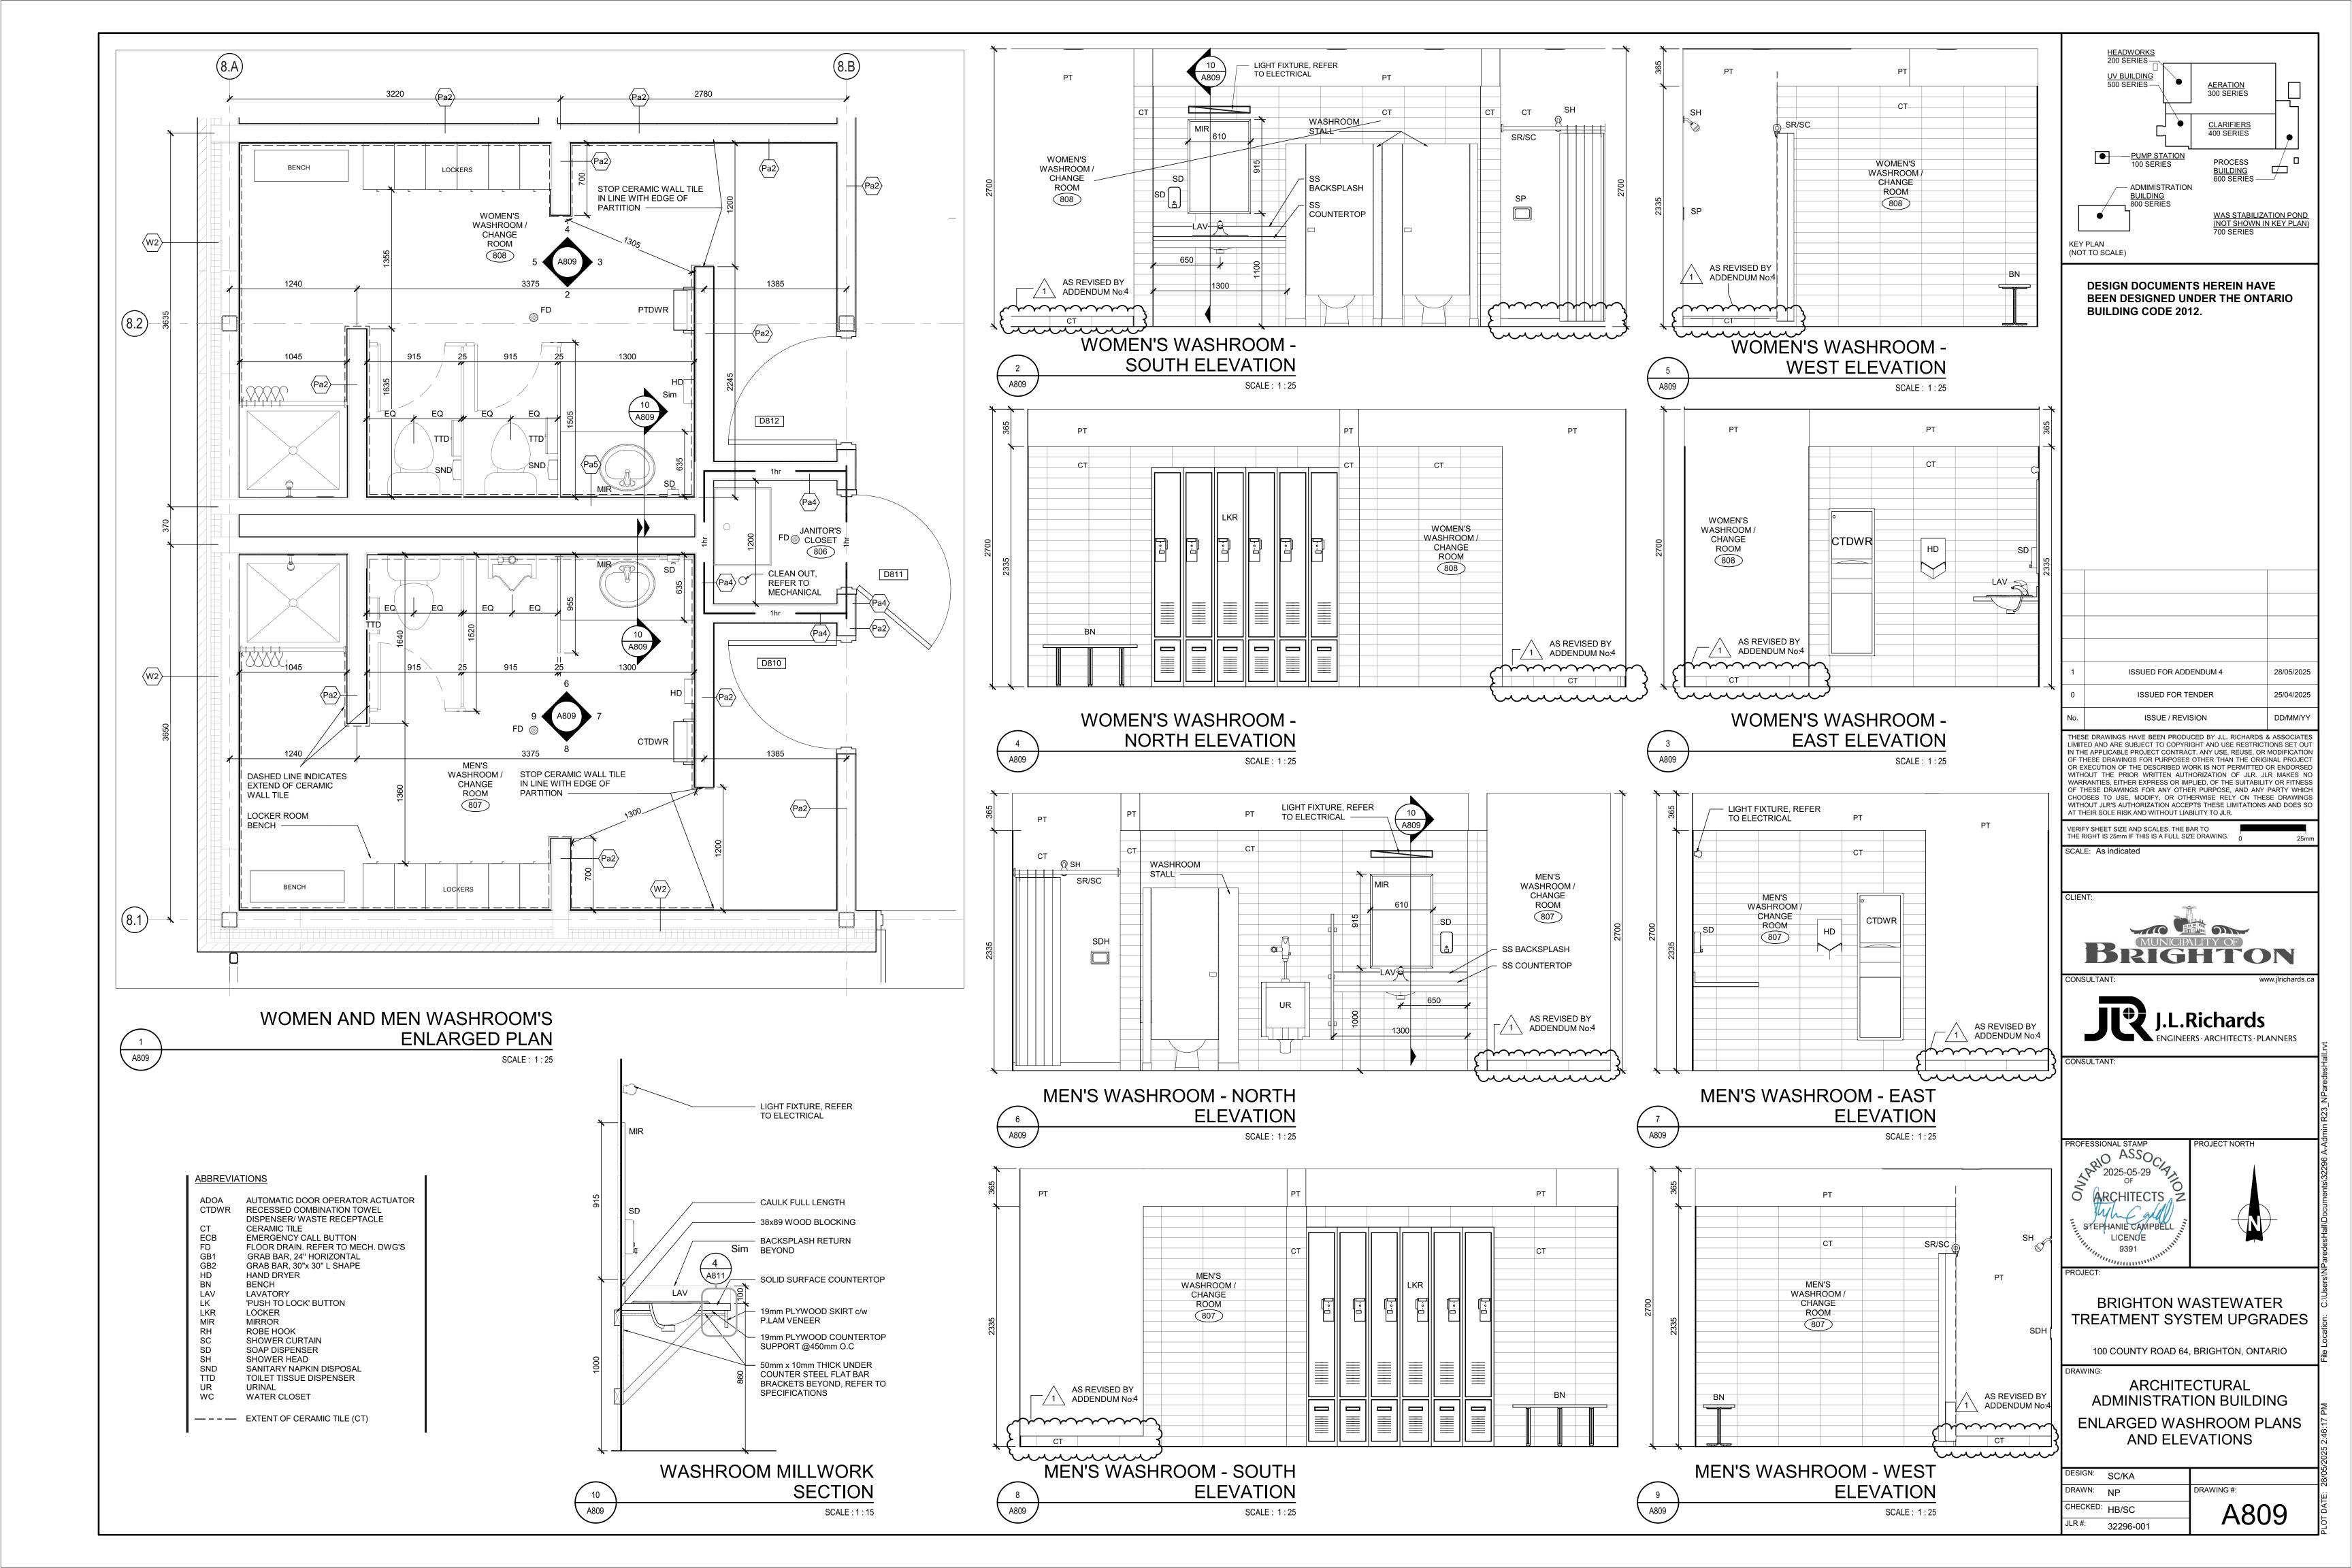

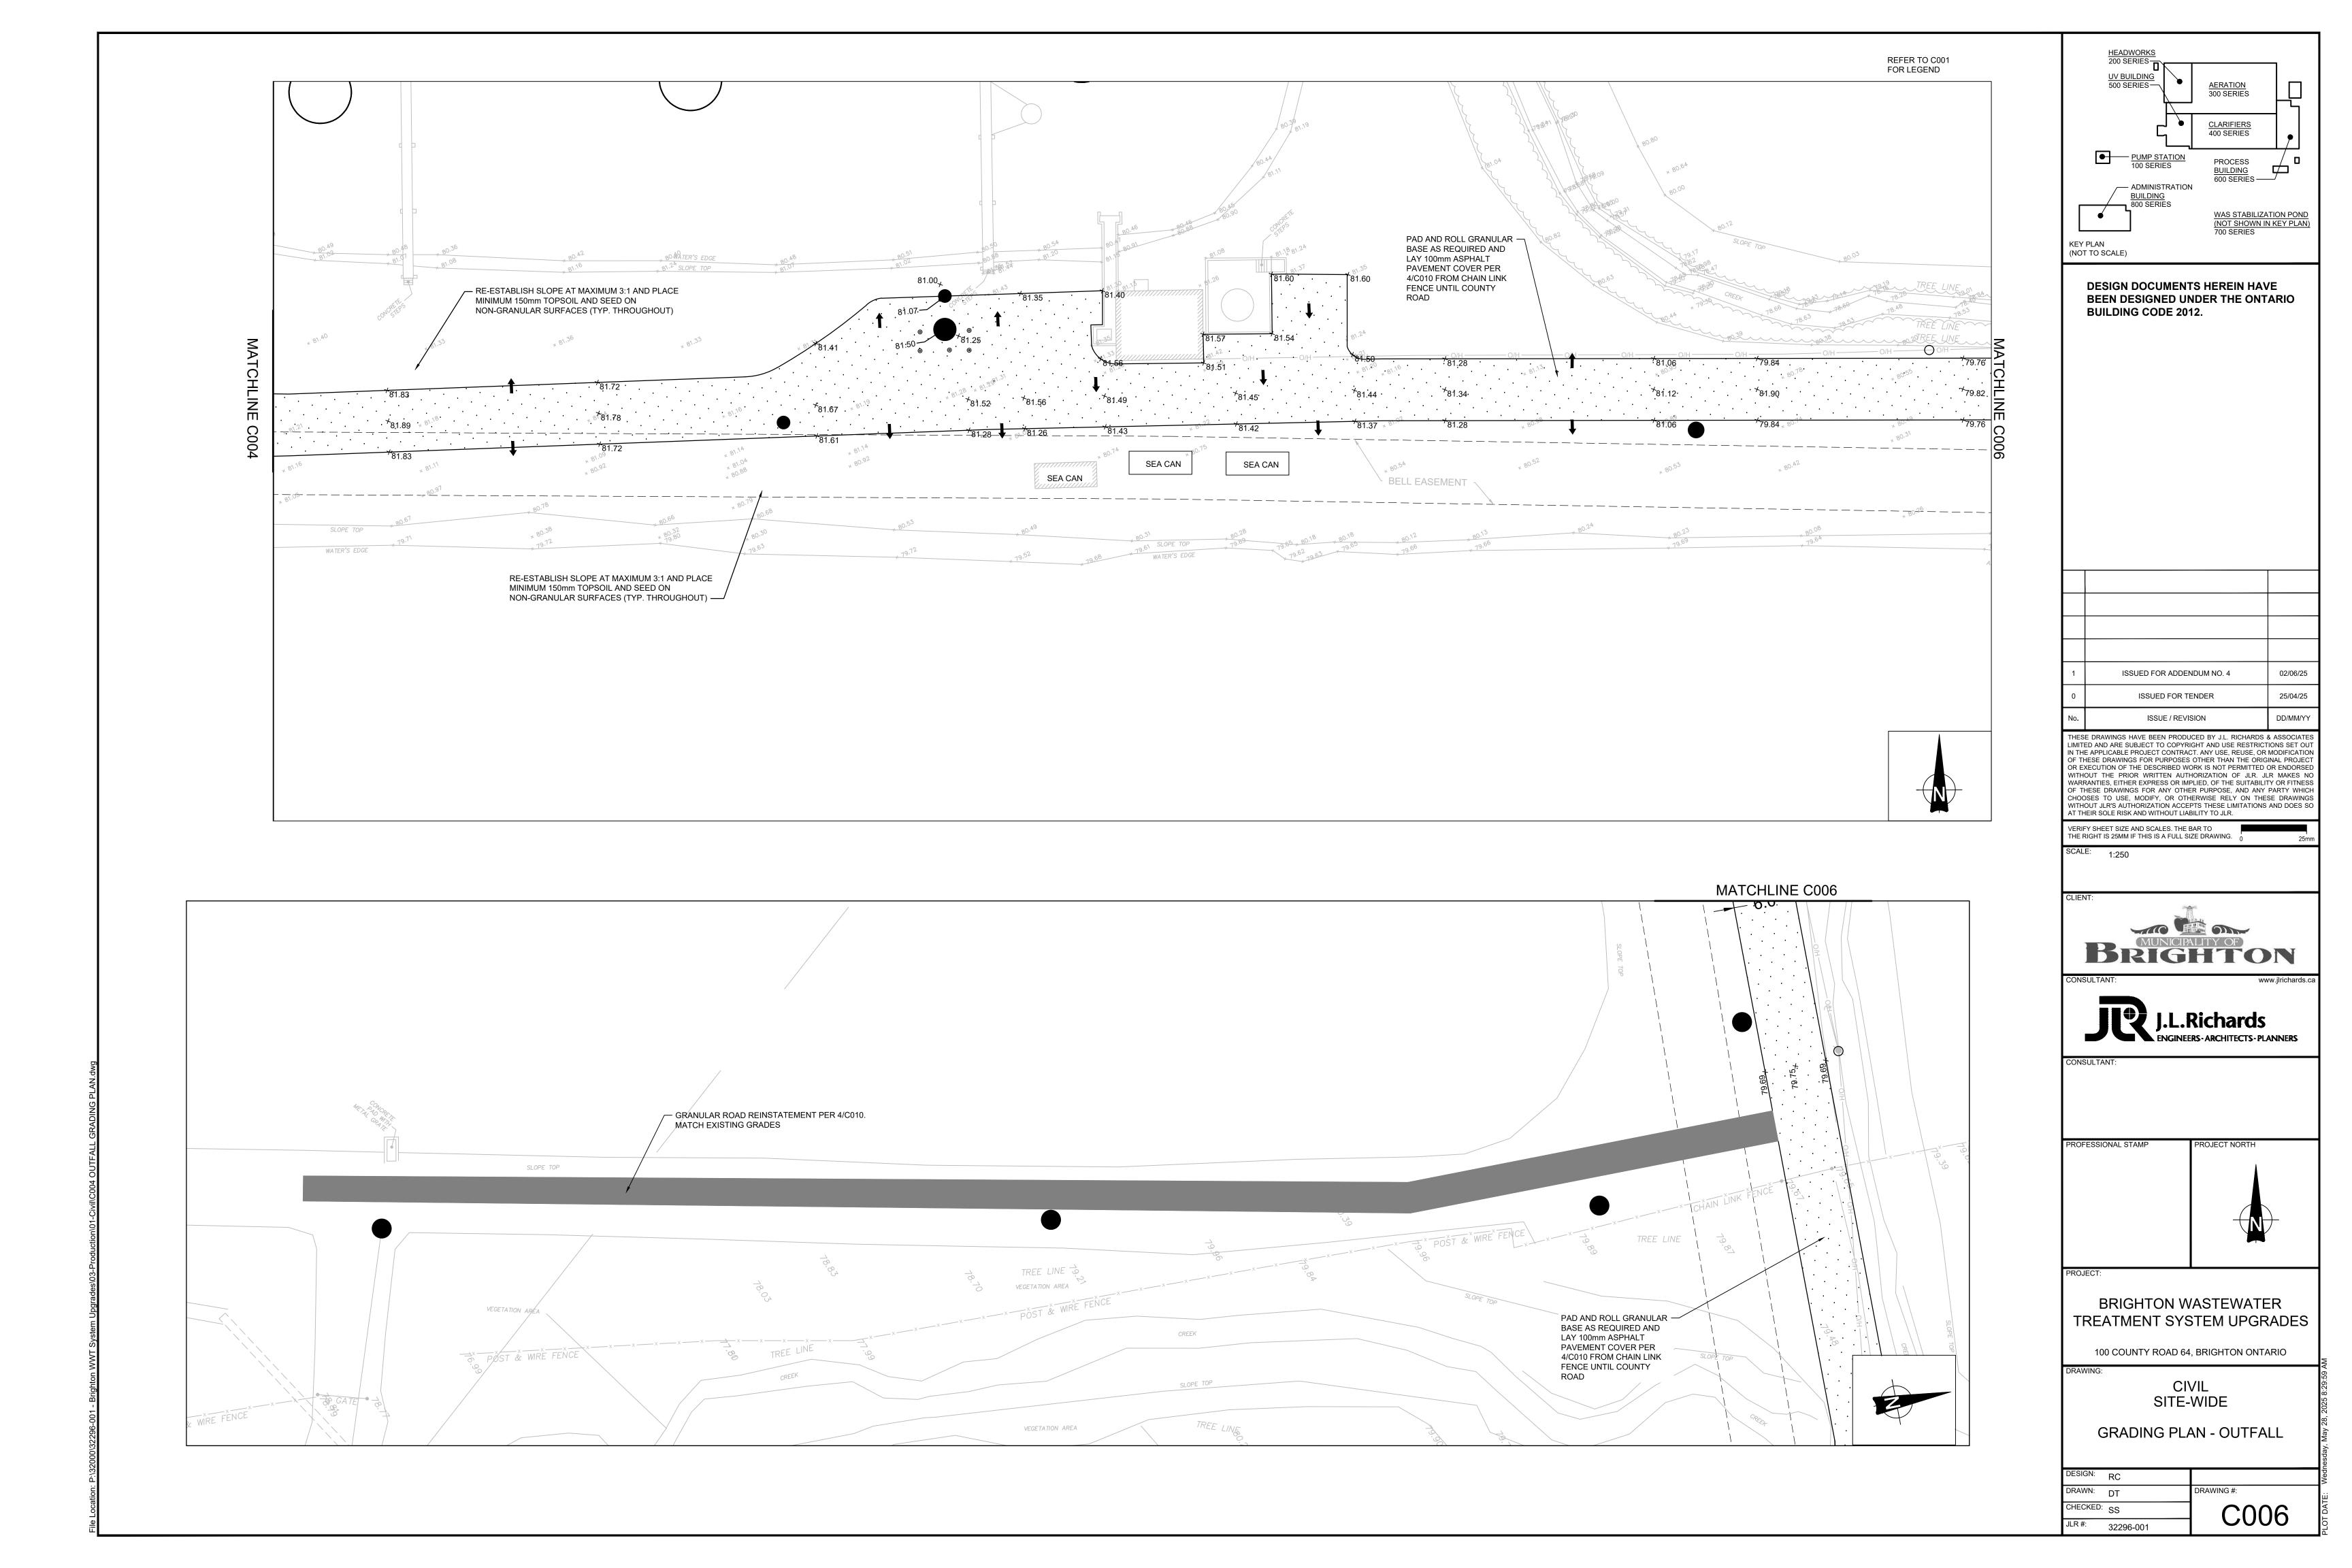

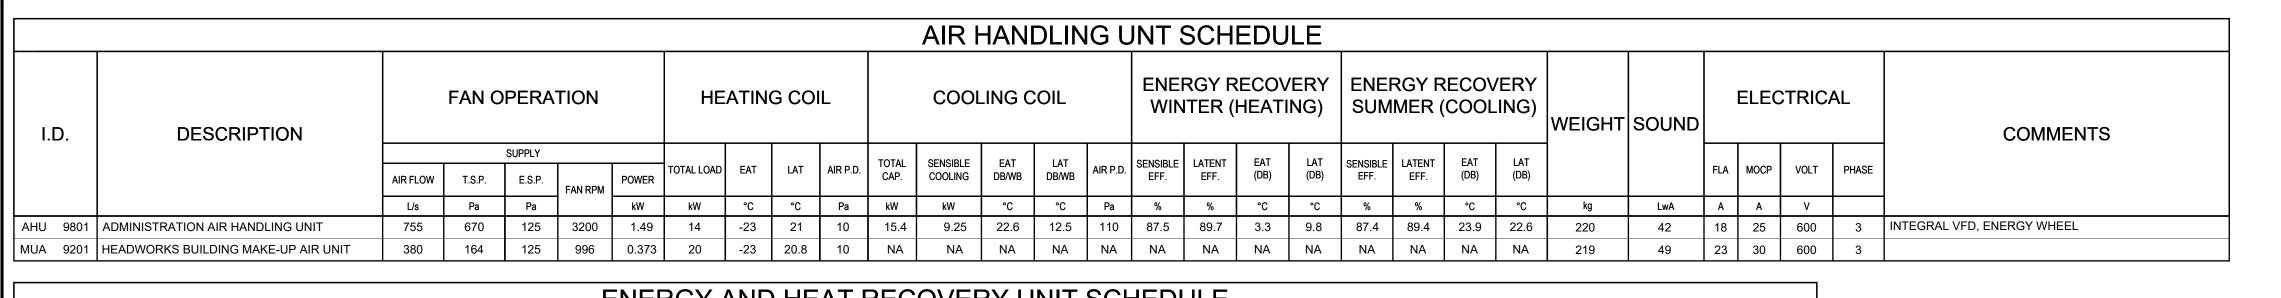

AS REVISED BY ADDENDUM No: 4

ENERGY AND HEAT RECOVERY UNIT SCHEDULE																				
				FAN	OPEF	RATIO	V				RECOV	ERY DAT	ГА			Е	LEC.	TRICA	<b>\</b> L	
	l I.D.	DESCRIPTION		SUPPLY			EXHAUST		WINTER	WINTER	WINTER	SUMMER	SUMMER	SUMMER	WEIGHT	<b>-</b> : •	моор	\ (O) =	5114.05	COMMENTS
l	1.0.	DESCINI HON	AIR FLOW E.S.P. POWER AIR FLO		AIR FLOW	E.S.P.	POWER	SENSIBLE EFFICIENCY			TOTAL SENSIBLE LATENT EFFICIENCY EFFICIENCY		TOTAL EFFICIENCY		FLA	MOCP	VOLT	PHASE	COMMENTO	
			L/s	Pa	kW	L/s	Pa	kW	%	%	%	%	%	%	kg	Α	Α	V		
	ERV 9501	UV BUILDING ENERGY RECOVERY UNIT	991	125	1.5	991	249	1.5	63	47	58	63	36	46	354	12.4	20	208	3	
	HRV 9601	PROCESS BUILDING HEAT RECOVERY UNIT	1586	125	2.24	1586	249	2.24	59	0	39	59	0	22	453	15.6	25	208	3	INTEGRAL VFD


ı						$\overline{}$	$\overline{}$		$\pm$		<del>_</del> _	$\overline{}$			—
L	$\overline{}$		$\checkmark$	$\overline{}$	<u> </u>	<u> </u>	<u> </u>					<u> </u>		$\supset$	
			OE	OUR	CO	NTR	OL	UNIT S	SCH	HED	ULE	•			
1				FAN O	PERA	ΓΙΟΝ				ELEC	CTRIC	AL		$\exists \vdash$	_
N	10	DESCRIPTION			SUPPLY			SOUND					COMMENTS	)	
	I.D.	DESCRIPTION	AIR FLOW	T.S.P.	E.S.P.	FAN RPM	POWER		FLA	LOAD	VOLT	PHASE	COMMENTS	$ \langle  $	I
1			L/s	Pa	Pa		kW	LwA	Α	HP	٧			/	
١	OCU 9201	HEADWORKS ODOUR CONTROL UNIT	472	2490	498	3265	3.72	110	6.1	5	600	3		]/ L	
ı	$\overline{}$														

	EXPANSION TANK SCHEDULE														
I.D.	DESCRIPTION	TANK VOLUME	ACCEPT. VOLUME	HORIZ/VERT		ISIONS	OPERATING PRESSURE								
l	L L mmØ mm KPa														
ET-9501	DIAPHRAGM THERMAL EXP. TANK	24.2	12.1	VERT.	305	457	380								
ET-9502	DIAPHRAGM THERMAL EXP. TANK	62.8	42.8	VERT.	381	635	380								
ET-9601	DIAPHRAGM THERMAL EXP. TANK	62.8	42.8	VERT.	381	635	380								
ET-9801	ET-9801 DIAPHRAGM THERMAL EXP. TANK 62.8 42.8 VERT. 381 635 380														

	ELECTRIC STEAM HUMIDIFIER SCHEDULE												
	I.D.	DESCRIPTION	MANUF./MODEL	OUTPUT	DUCT SIZE	ELE	CTRIC		CONTROL	COMMENTS			
ı						KW	VOLT	PH					
				Kg/h	mm x mm								
	HUM-9801	ADMIN BUILDING HUMIDIFIER	CAREL./UE015XN0U1	10.4	450X300	11.25	600	3	BACNET ETHERNET CARD				

	DOMESTIC WATER HEATER TANK SCHEDULE													
I.D	DESCRIPTION	LOCATION	MANUF./MODEL		VERY ACITY		ECTION ZE	E	LECTRI	ICAI	L		COMMENTS	
1.0	DESCRIPTION	LOCATION	MANUF./MODEL	TEMP. RISE	RISE L/m		C.W.	ELEM	ENTS		POWER		COMMENTS	
						H.W.	<b>5</b>	QUANTITY	WATTAGE	KW	VOLT	PH		
				°C		mm	mm							
DHWT-	9501 UV BUILDING MHW TANK	MECHANICAL ROOM 503	A.O. SMITH ./ 50D	55	0.5	19	19	1	2000	2	208	3		
DHWT-	9502 UV BUILDING SHW TANK	MECHANICAL ROOM 503	RUUD ./ EVRO	55	3.91	38	38	1	15000	15	208	3		
DHWT-	9601 PROCESS BUILDING DHW TANK	MECHANICAL ROOM 601	RUUD ./ EVRO	55	3.91	38	38	1	15000	15	208	3		
DHWT-	9801 ADMIN BUILDING DHW TANK	MECHANICAL ROOM 810	RUUD ./ EVRO	55	3.91	38	38	1	15000	15	208	3		

	)		UNIT H	IEATER & CA	ABINE	T HEA	TER S	CHE	DULE		
			DECODIDEION	7.05		RATING ATA	EL	ECTRIC	AL	00111451150	
	)	.D.	DESCRIPTION	TYPE	CAPACITY	AIR FLOW	RATING	VOLTS	PH	COMMENTS	
$\mathcal{J}$	CUH	9501	ELECTRIC CABINET UNIT HEATER	CABINET	kW 4	L/s 118	kW 4	V 208	1	WALL MOUNT T-STAT	
							·		1		
	CUH	9601	ELECTRIC CABINET UNIT HEATER	CABINET	2	118	2	208		WALL MOUNT T-STAT	
	CUH	9602	ELECTRIC CABINET UNIT HEATER	CABINET	2	118	2	208	1	WALL MOUNT T-STAT	
	CUH	9801	ELECTRIC CABINET UNIT HEATER	CABINET	2	118	2	208	1	WALL MOUNT T-STAT	
	EBB	9801	ELECTRIC BASEBOARD HEATER	WALL-MOUNTED	0.3	NA NA	0.3	120	1		
	EBB	9802	ELECTRIC BASEBOARD HEATER	WALL-MOUNTED	0.3	NA NA	0.3	120	1		
	EBB	9803	ELECTRIC BASEBOARD HEATER	WALL-MOUNTED	0.3	NA NA	0.3	120	1		
	EBB	9804	ELECTRIC BASEBOARD HEATER	WALL-MOUNTED	1	NA NA	1	120	1		
	EBB	9805	ELECTRIC BASEBOARD HEATER	WALL-MOUNTED	1.5	NA 	0.75	120	1		
	EBB	9806	ELECTRIC BASEBOARD HEATER	WALL-MOUNTED	0.75	NA 	0.75	120	1		
	EBB	9807	ELECTRIC BASEBOARD HEATER	WALL-MOUNTED	0.75	NA	0.75	120	1		
	EBB	9808	ELECTRIC BASEBOARD HEATER	WALL-MOUNTED	0.75	NA	0.75	120	1		
]	EBB	9809	ELECTRIC BASEBOARD HEATER	WALL-MOUNTED	1.25	NA	1.25	120	1		
	EBB	9810	ELECTRIC BASEBOARD HEATER	WALL-MOUNTED	1.5	NA	1.5	120	1		
	EBB	9811	ELECTRIC BASEBOARD HEATER	WALL-MOUNTED	0.3	NA	0.3	120	1		
	EBB	9812	ELECTRIC BASEBOARD HEATER	WALL-MOUNTED	0.75	NA	0.75	120	1		
	EBB	9813	ELECTRIC BASEBOARD HEATER	WALL-MOUNTED	1	NA	1	120	1		
	EBB	9814	ELECTRIC BASEBOARD HEATER	WALL-MOUNTED	0.75	NA	0.75	120	1		
(	EBB	9815	ELECTRIC BASEBOARD HEATER	WALL-MOUNTED	0.5	NA	0.5	120	1		
\	EBB	9816	ELECTRIC BASEBOARD HEATER	WALL-MOUNTED	0.75	NA ^	0.75	120	1		
	EBB	9817	ELECTRIC BASEBOARD HEATER	WALL-MOUNTED	0.5	NA NA	0.5	120			AS REVISED BY ADDENDUM No: 4
	EBB	9818	ELECTRIC BASEBOARD HEATER	WALL-MOUNTED	1.25	NA	1.25	120	1		
	EBB	9819	ELECTRIC BASEBOARD HEATER	WALL-MOUNTED	1	NA	1	120	1		
	EBB	9820	ELECTRIC BASEBOARD HEATER	WALL-MOUNTED	0.3	NA	0.3	120	1		
	EBB	9821	ELECTRIC BASEBOARD HEATER	WALL-MOUNTED	0.5	NA	0.5	120	1		
	EUH	9201	ELECTRIC UNIT HEATER	WALL-MOUNTED	3	240.7	3	600	3	WALLMOUNT T-STAT	
	EUH	9202	ELECTRIC UNIT HEATER	WALL-MOUNTED	3	240.7	3	600	3	WALLMOUNT T-STAT	
	EUH	9203	ELECTRIC UNIT HEATER	WALL-MOUNTED	10	330.4	10	600	3	WALLMOUNT T-STAT	
	EUH	9204	ELECTRIC UNIT HEATER	WALL-MOUNTED	4	240.7	4	600	3	WALLMOUNT T-STAT	
	EUH	9205	ELECTRIC UNIT HEATER	WALL-MOUNTED	10	330.4	10	600	3	WALLMOUNT T-STAT	
	EUH	9301	ELECTRIC UNIT HEATER	WALL-MOUNTED	4	240.7	4	600	3	WALLMOUNT T-STAT	
	EUH	9302	ELECTRIC UNIT HEATER	WALL-MOUNTED	4	240.7	4	600	3	WALLMOUNT T-STAT	
	EUH	9303	ELECTRIC UNIT HEATER	WALL-MOUNTED	4	240.7	4	600	3	WALLMOUNT T-STAT	
	EUH	9501	ELECTRIC UNIT HEATER	WALL-MOUNTED	2	240.7	2	600	3	WALLMOUNT T-STAT	
	EUH	9502	ELECTRIC UNIT HEATER	WALL-MOUNTED	10	330.4	10	600	3	WALLMOUNT T-STAT	
	EUH	9503	ELECTRIC UNIT HEATER	WALL-MOUNTED	10	330.4	10	600	3	WALLMOUNT T-STAT	
	EUH	9504	ELECTRIC UNIT HEATER	WALL-MOUNTED	5	330.4	5	600	3	WALLMOUNT T-STAT	
	EUH	9601	ELECTRIC UNIT HEATER	WALL-MOUNTED	7.5	330.4	7.5	600	3	WALLMOUNT T-STAT	
	EUH	9602	ELECTRIC UNIT HEATER	WALL-MOUNTED	7.5	330.4	7.5	600	3	WALLMOUNT T-STAT	
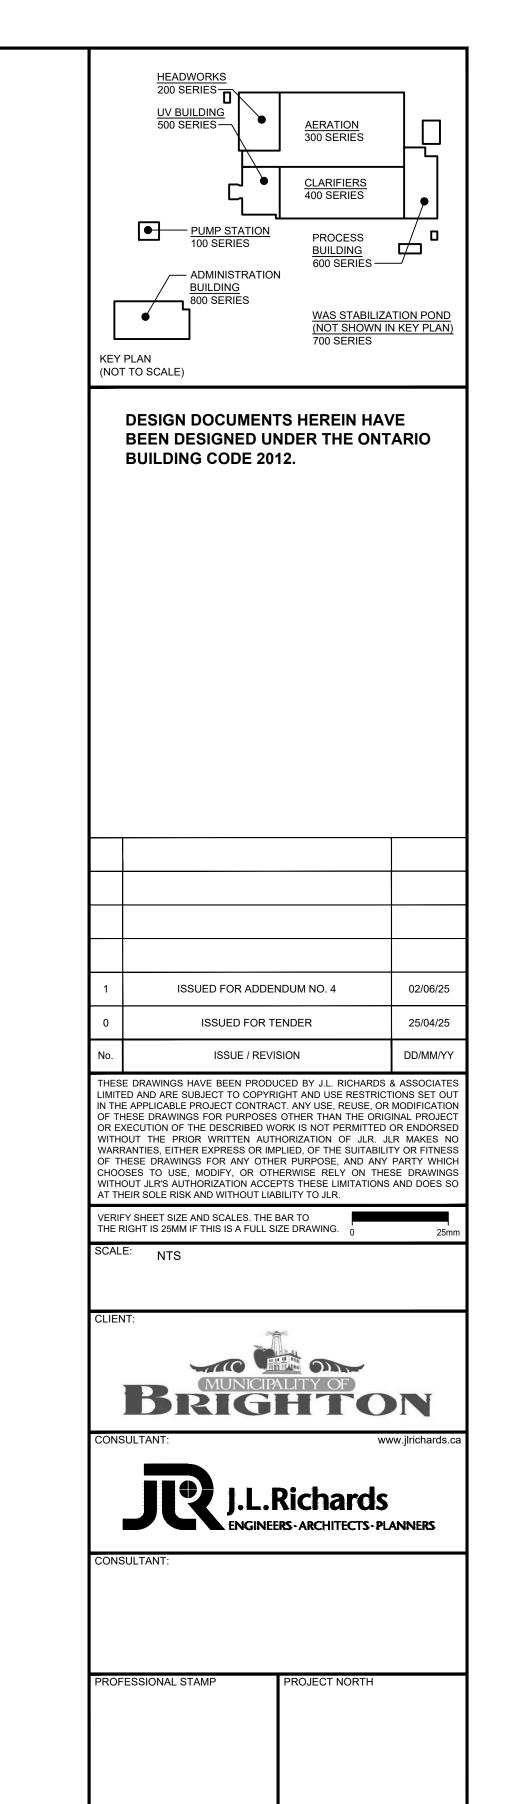

JLR #: 32296-001

**BRIGHTON WASTEWATER** TREATMENT SYSTEM UPGRADES 100 COUNTY ROAD 64, BRIGHTON ONTARIO **MECHANICAL** SITE WIDE MECHANICAL SCHEDULES SHEET 1 DRAWN: CI CHECKED: PE MID001

